


T. 14 S. R. 5 W. W.M.

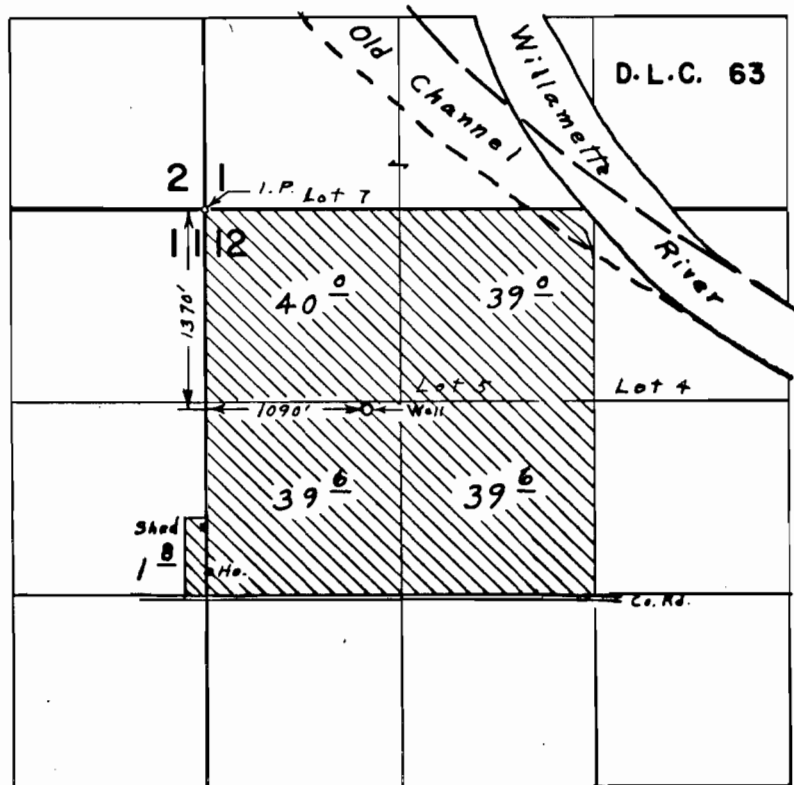

FINAL PROOF SURVEY
UNDER

Application No. G-4942 Permit No. G-4664
G-3498 Permit No. G-3295
IN NAME OF

CROCKER BROTHERS (HERRON PLACE)

Surveyed March 30, 1970, by L. E. Gould