


# T.13 & 14S.R.2W.W.M.

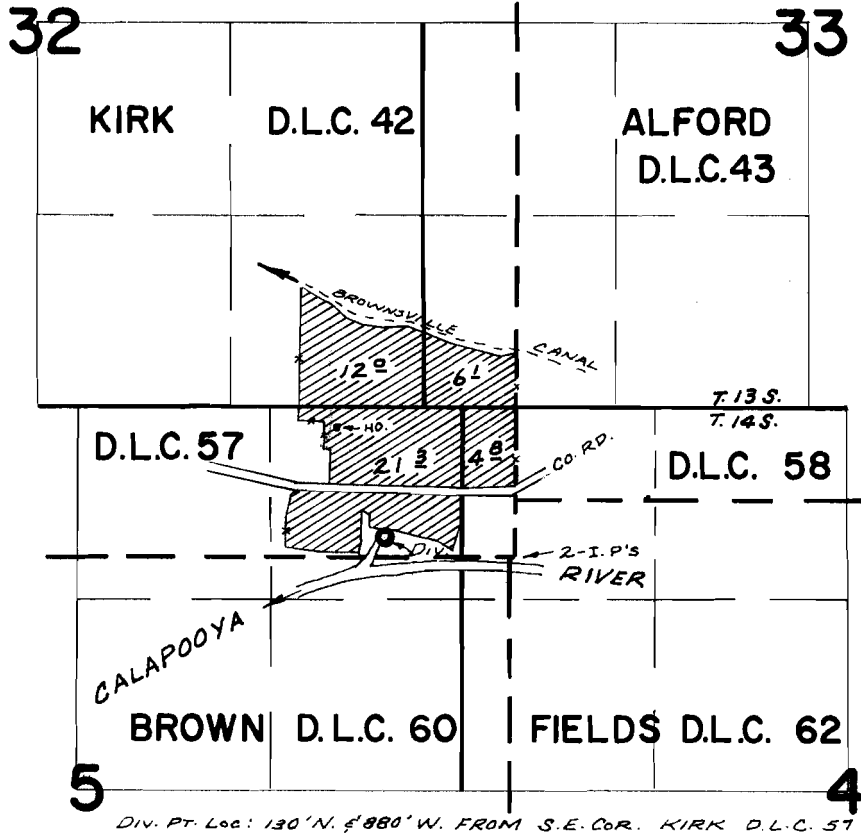

44517

33312

BERT W. & ARLENE T. CURTIS

JULY 31, 1970 R. MUGKEN