


T.I.S.R.I.O.E.W.M.

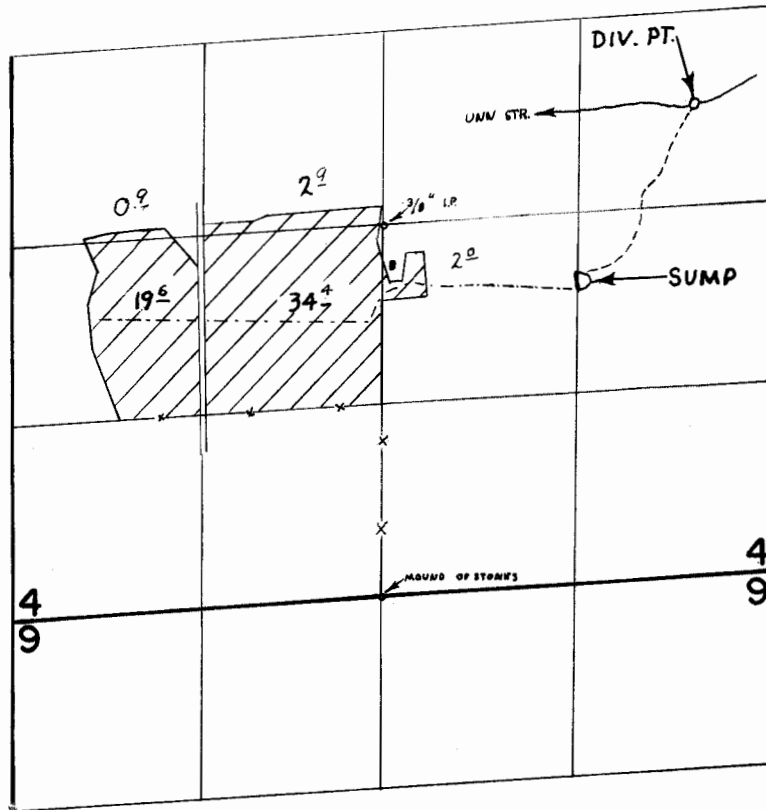

FINAL PROOF SURVEY UNDER

Application No. 31745 Permit No. 25083
IN NAME OF

ARTHUR M. & DOROTHY BIBB

Surveyed NOV. 3, 1960, by C. O. BARTELS.