
# T. 35 S. R. 1 W. W.M.

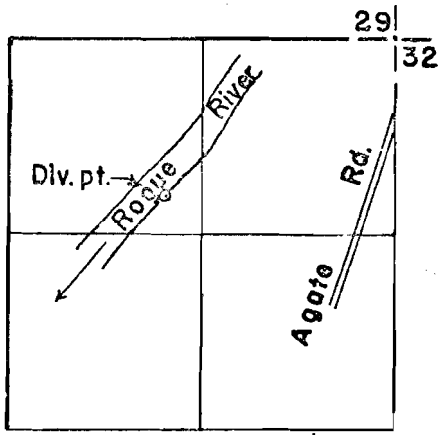


Div. pt. is located 1060' S. & 1580' W. from the N. 1/4 cor. of sec. 32

## FINAL PROOF SURVEY
UNDER

Trans. No. G-78
Application No. ..... Permit No. .....
IN NAME OF

Fred W. & Ruth A. Greene

Surveyed Sept 2 1971, by D.C. Hendrix

lmc