


T. 40 S., R. 3 W., W.M.

Scale:
8 inches = 1 mile

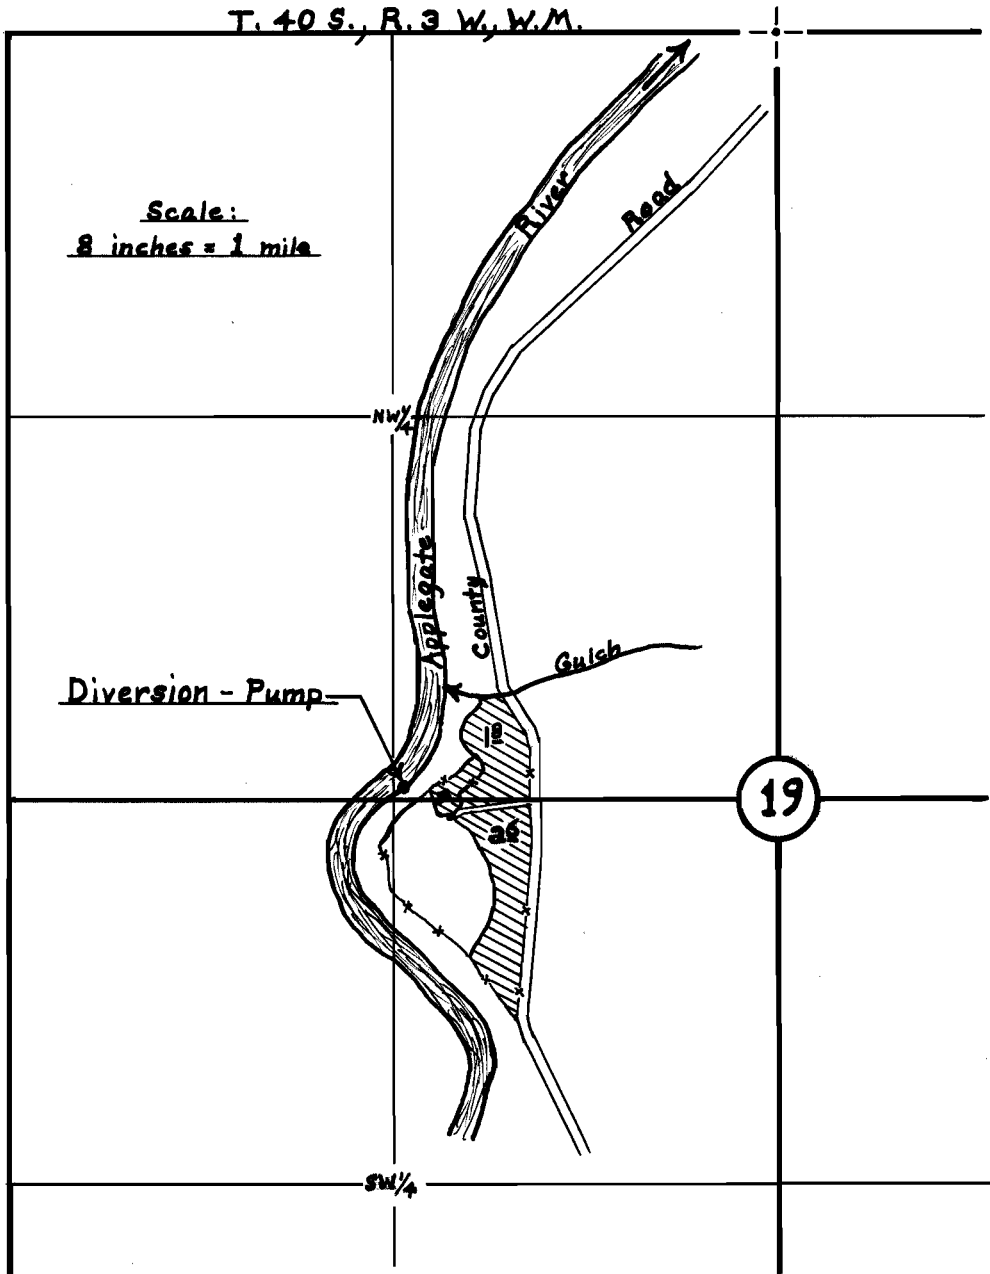

FINAL PROOF SURVEY

UNDER

Application No. 29464... Permit No. 23187....

IN NAME OF

.....Gerald Buck.....

Surveyed Feb. 28, 1958, by D.C. Hendrix, W.M.