
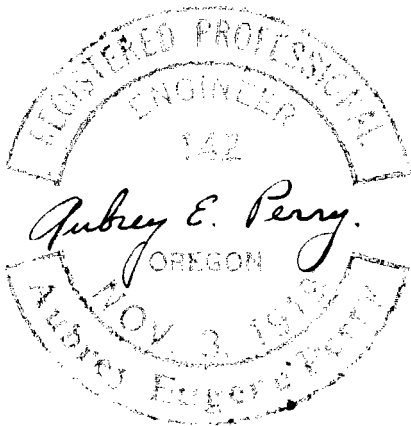


MAP
ROGER'S IRRIGATION DITCHES.
 Scale 2" = 1 Mile.

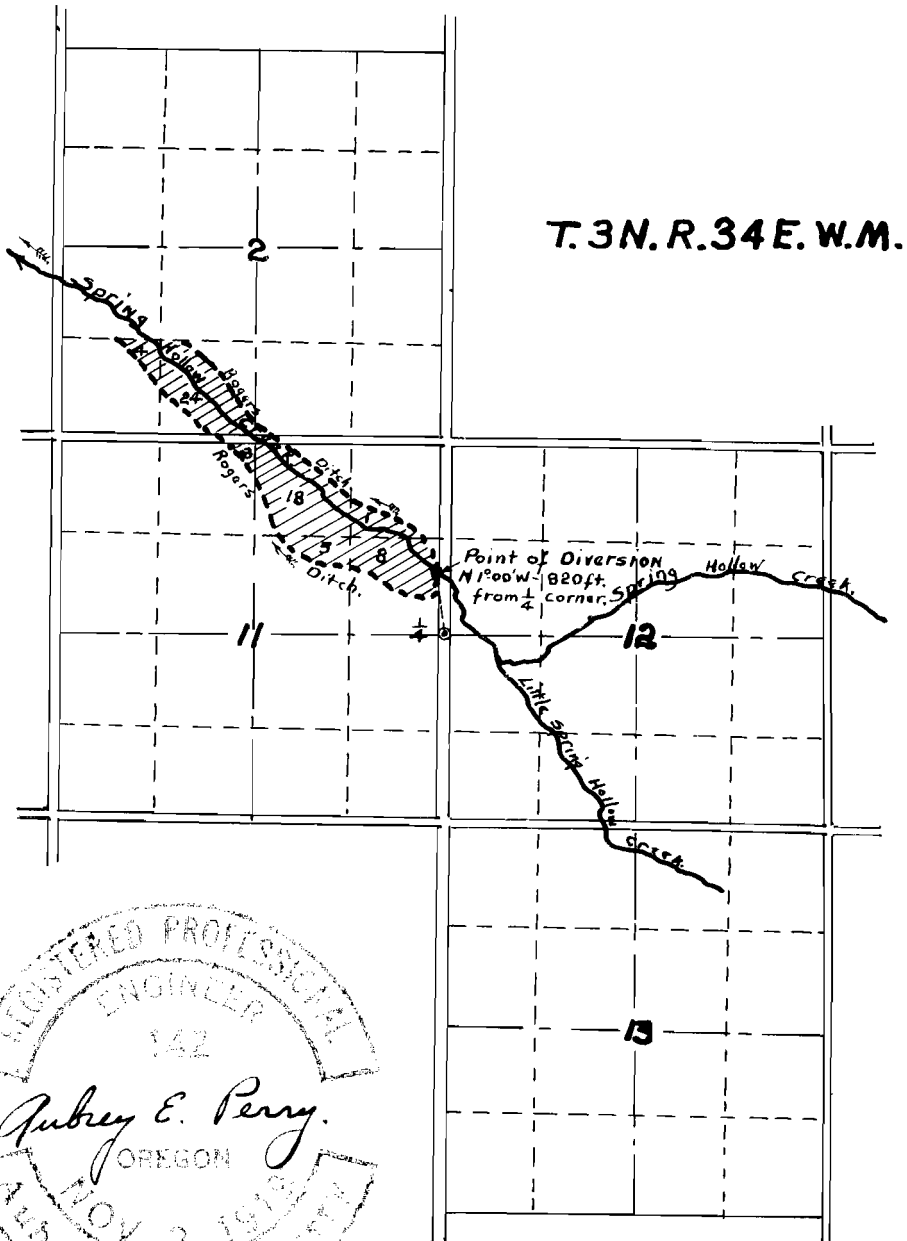

7833
 5046