


# T.9S.R.40E.W.M.

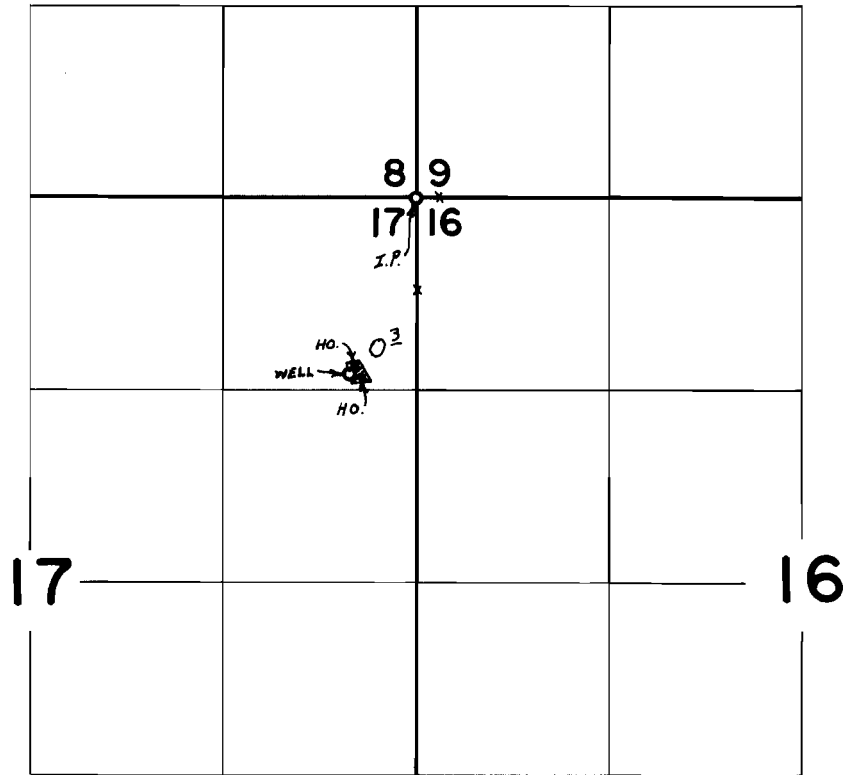

WELL LOC. 1220'S. & 960'W. FROM NE COR. SEC. 17

## FINAL PROOF SURVEY UNDER

Application No. G-1969 Permit No. G-1850  
IN NAME OF

W.P. RIORDAN

Surveyed AUG. 7 1970, by L.E. GOULD