


# T. 8 S. R. 41 E. W. M.

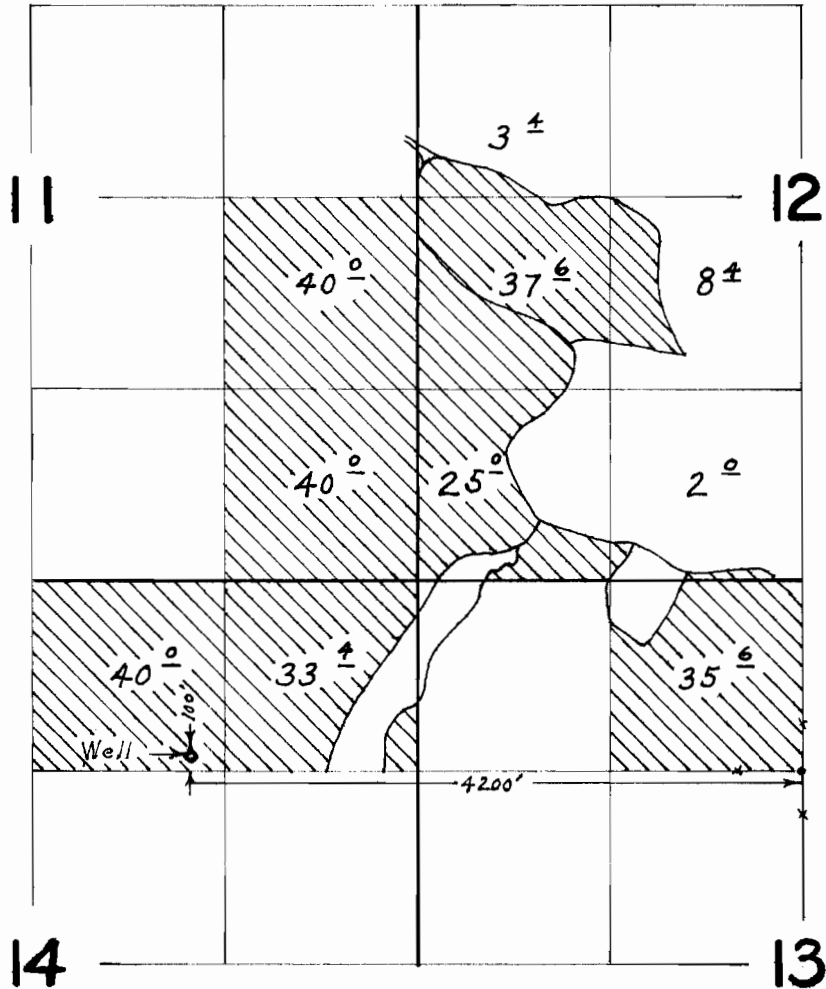

## FINAL PROOF SURVEY

2005

Approved by G-2693 G-2498

ROBERT J. & MARGARET E. STEWARD & MORRISSEY, A PARTNERSHIP  
 STEWARD, PATRICK C. & MORRISSEY, ETHEL JOY

Surveyed July 17, 1970 by L. E. Gould