


T. 8 S. R. 41 E. W. M.

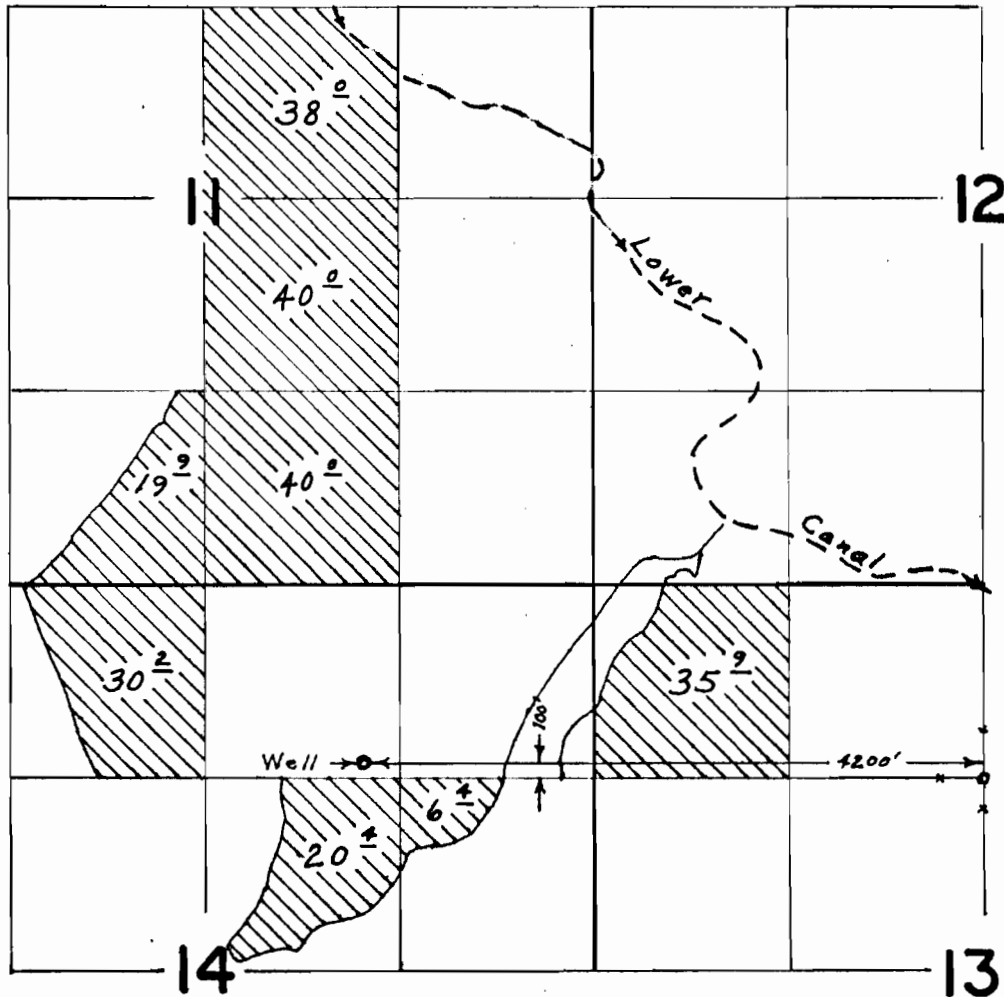

FINAL PROOF SURVEY

UNDER

Application No. G-2694 Permit No. G-2499

IN NAME OF

PATRICK C. MORRISSEY

Surveyed July 17, 1970, by L. E. Gould