


T. 8 S. R. 40 E. W. M.

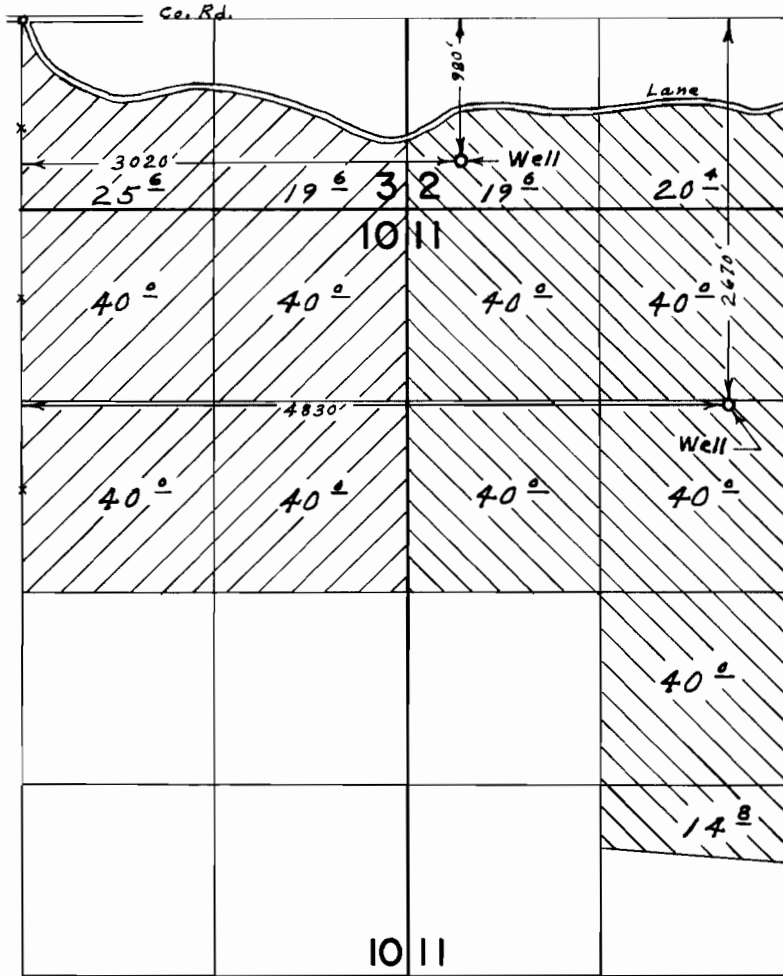

FINAL PROOF SURVEY UNDER

Application No. G-3750 Permit No. G-3159
G-3751 G-3160
 IN NAME OF

LIONEL H. SCHETKY

Surveyed July 15, 1970, by L. E. Gould