


4518
T36S R25E
3800

N.

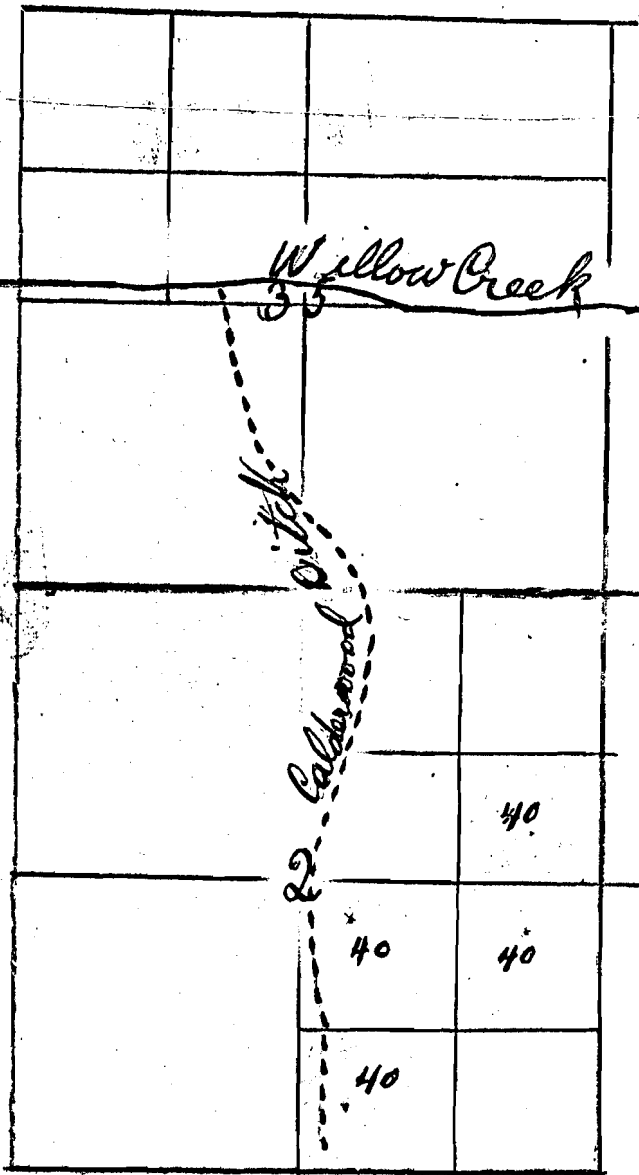

OFFICE OF STATE ENGINEER
RECEIVED
APR 3 1920
SALEM, OREGON.

Application No. 7188
Permit No. 4518

The above is as accurate as possible
without complete survey.

7188