


# T. 6 & 7 S. R. 45 E. W.M.

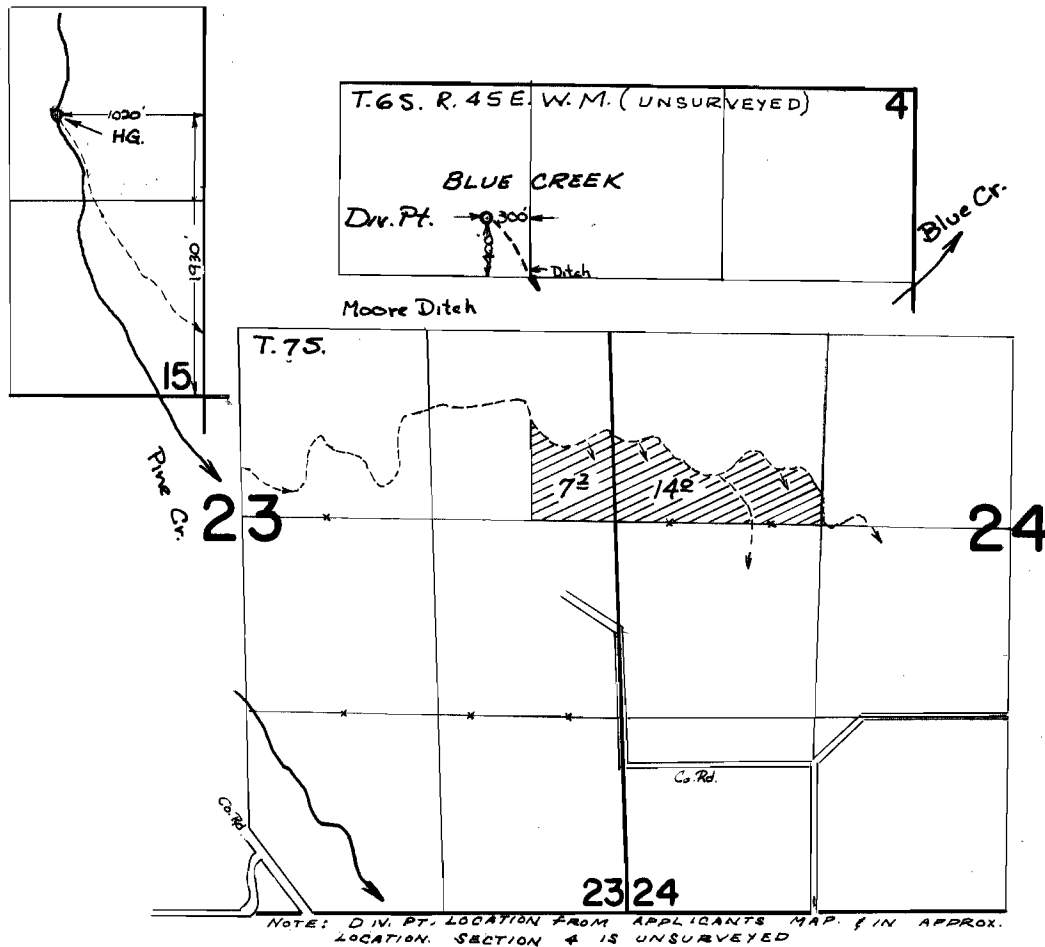

## FINAL PROOF SURVEY UNDER

Application No. 38564 Permit No. 28731  
IN NAME OF

FLOYD W. & MILDRED JOHNSON

Surveyed 21 JULY 1970, by D. R. BUELL