


T. 12 S. R. 38 E. W. M.

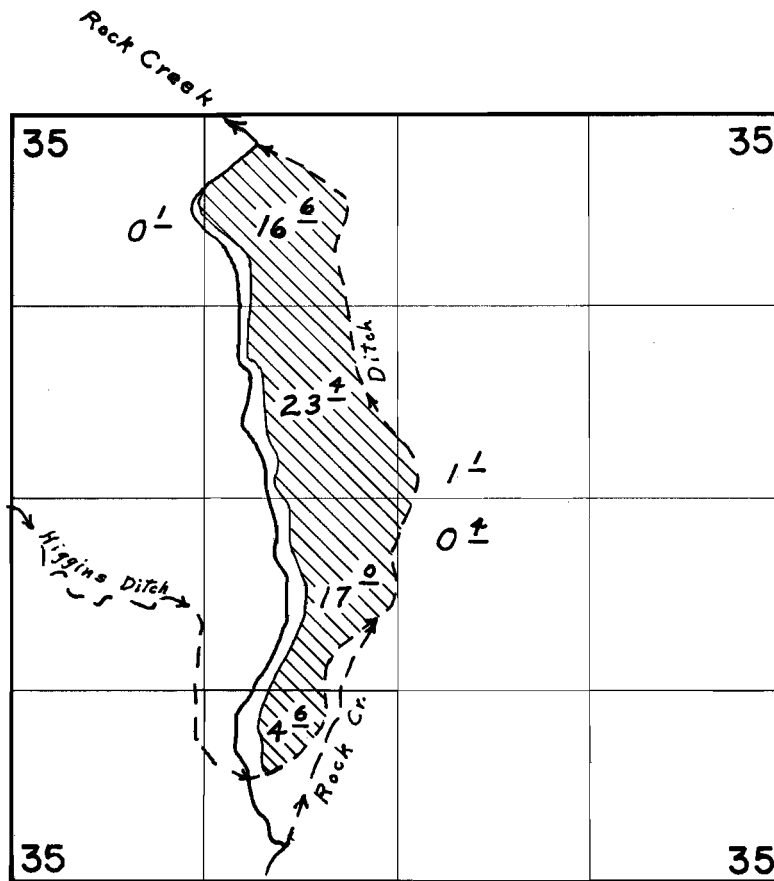

FINAL PROOF SURVEY
UNDER

Application No. 40088 Permit No. 29756
IN NAME OF

ESTATE OF H. J. COOMBS

Surveyed Oct. 16 1969, by L. E. Gould