


T. 6 & 7 S. R. 38 E. W. M.

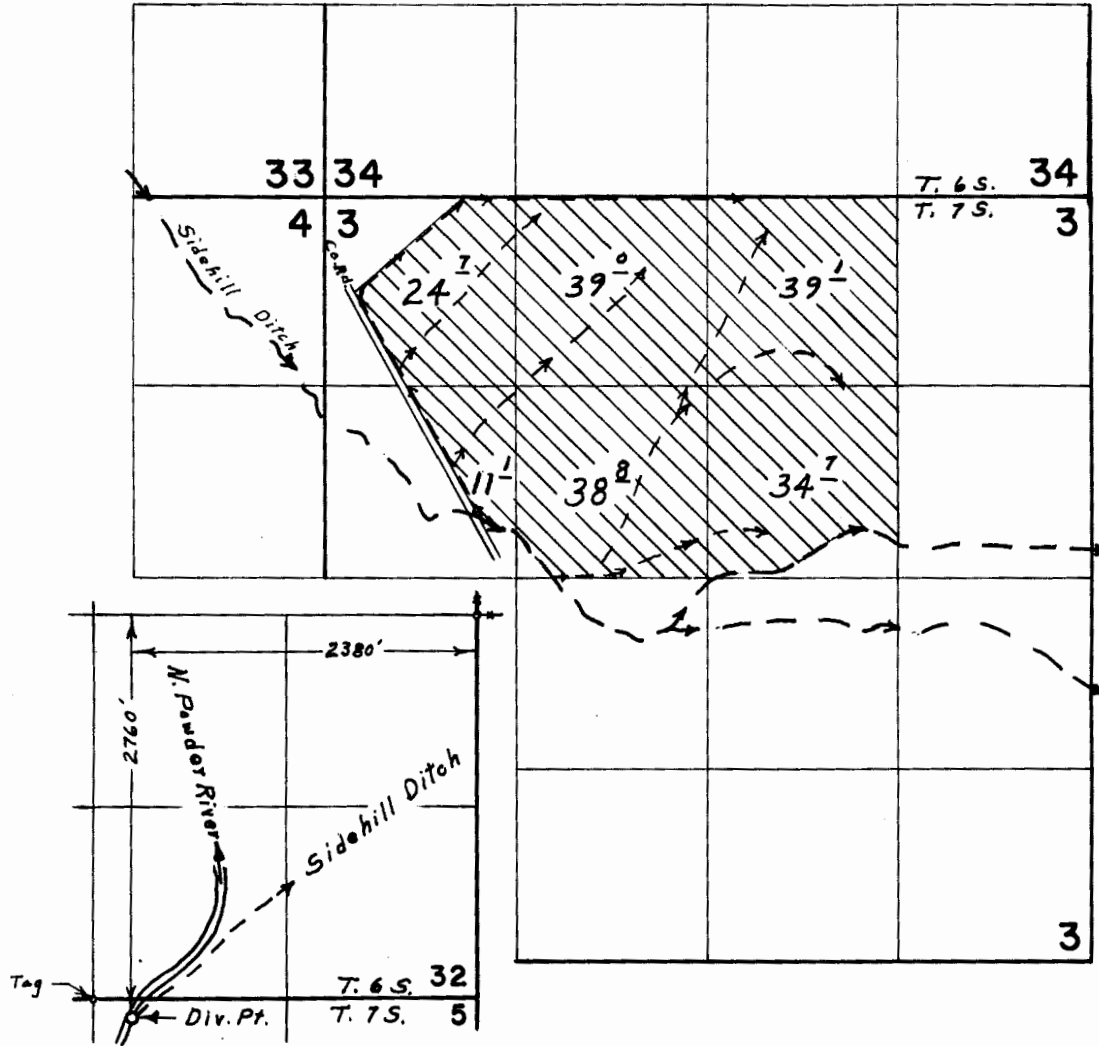

FINAL PROOF SURVEY UNDER

Application No. 40714 Permit No. 30328
IN NAME OF

ALVIA H. PETERS

Surveyed July 1, 1970, by L. E. Gould