


T. 7S. R. 38E. W.M.

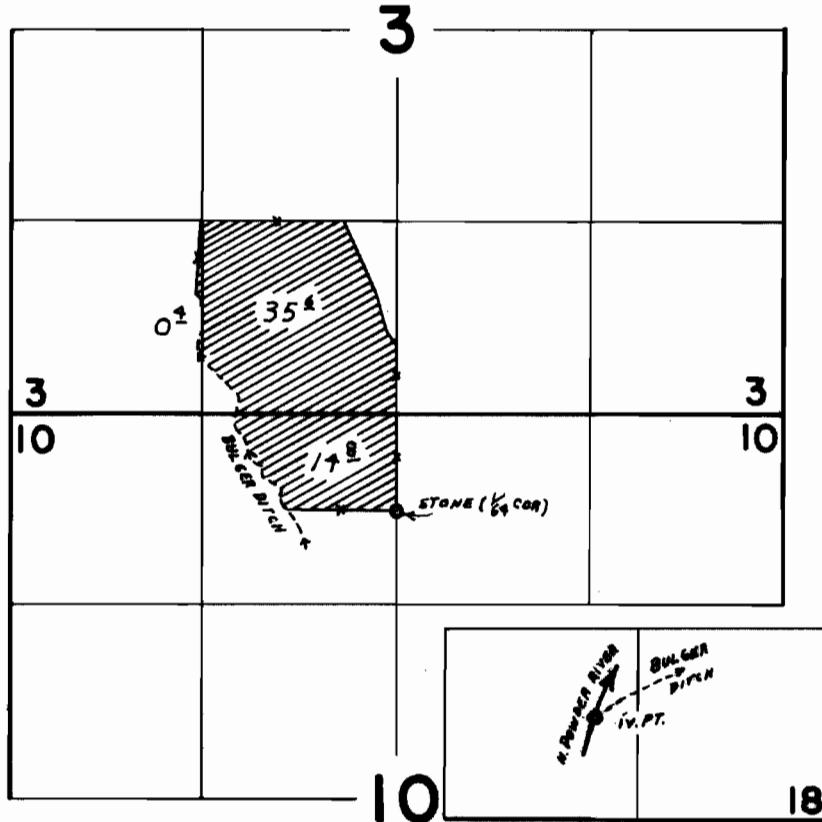

DIV. PT. LOC. 700' N. & 1620' W. FROM SE COR. SEC. 18

FINAL PROOF SURVEY UNDER

Application No. 41262 Permit No. 30770
IN NAME OF

LESTER BOND

Surveyed JULY 1 1970, by A. E. GOULD