T. 8 S. R. 39 E. W. M.

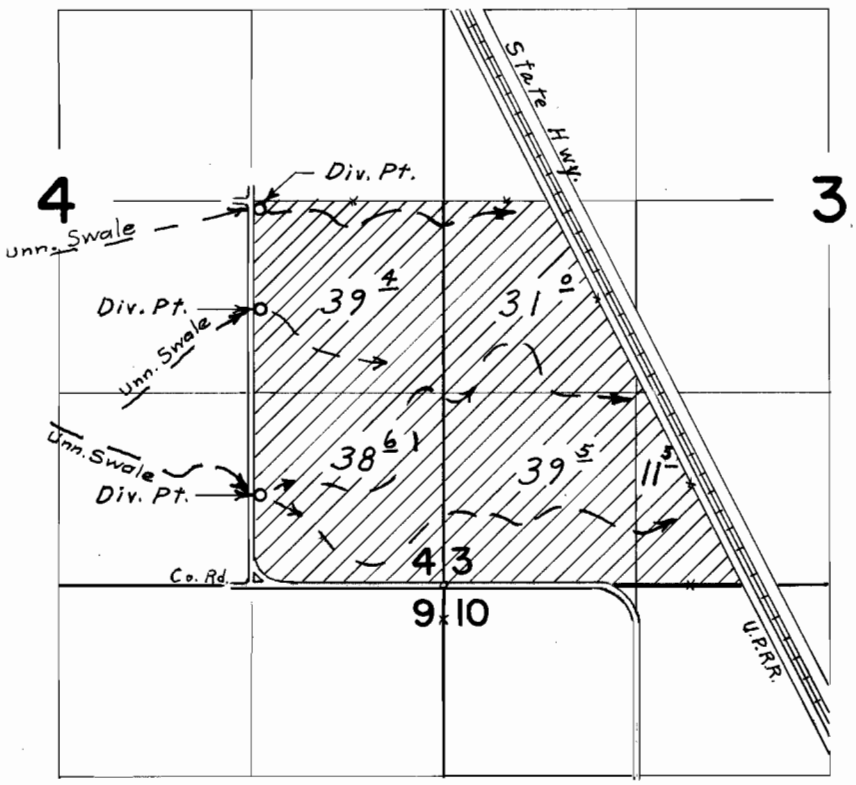

Div. Pts. located: 2580' N. & 1290' W.; 1900' N. & 1290' W.; 620' N. & 1290' W. all from S.E. Cor. Sec. 4

FINAL PROOF SURVEY
UNDER

Application No. 41582 Permit No. 31015
IN NAME OF

EMIL L. KIPLING

Surveyed July 7, 1970, by L. E. Gould

BBB-4KK-263 & 1970-U