


T. 7 S. R. 38 E. W. M.

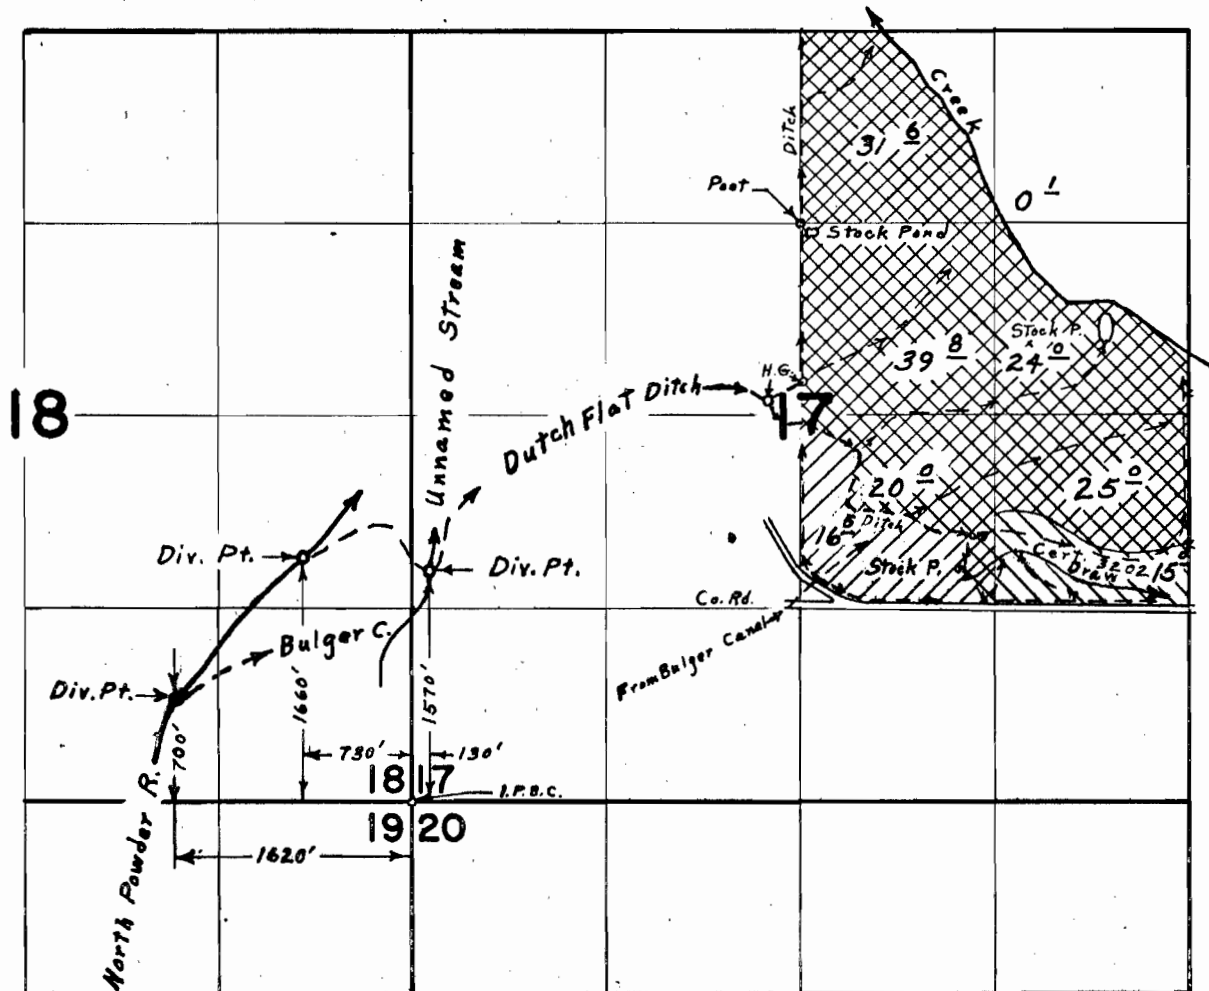

FINAL PROOF SURVEY

UNDER

Application No. 42761 Permit No. 31975



IN NAME OF

DWIGHT PERKINS

Surveyed May 19, 1970, by L. E. Gould