


# T. 7 S. R. 45 E. W.M.

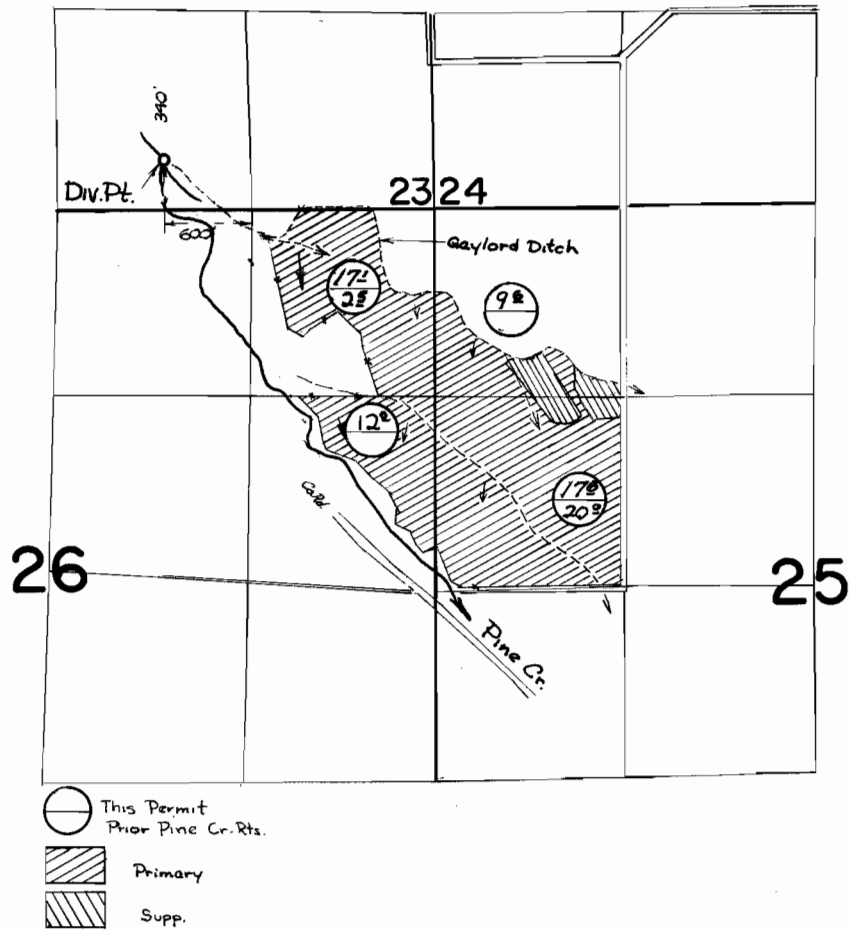

## FINAL PROOF SURVEY UNDER

Application No. 41743      Permit No. 31162  
IN NAME OF

VERNON DENNIS

Surveyed 14 JULY 1970, by D. R. BUELL