


T. 8 S. R. 3 8 E. W. M.

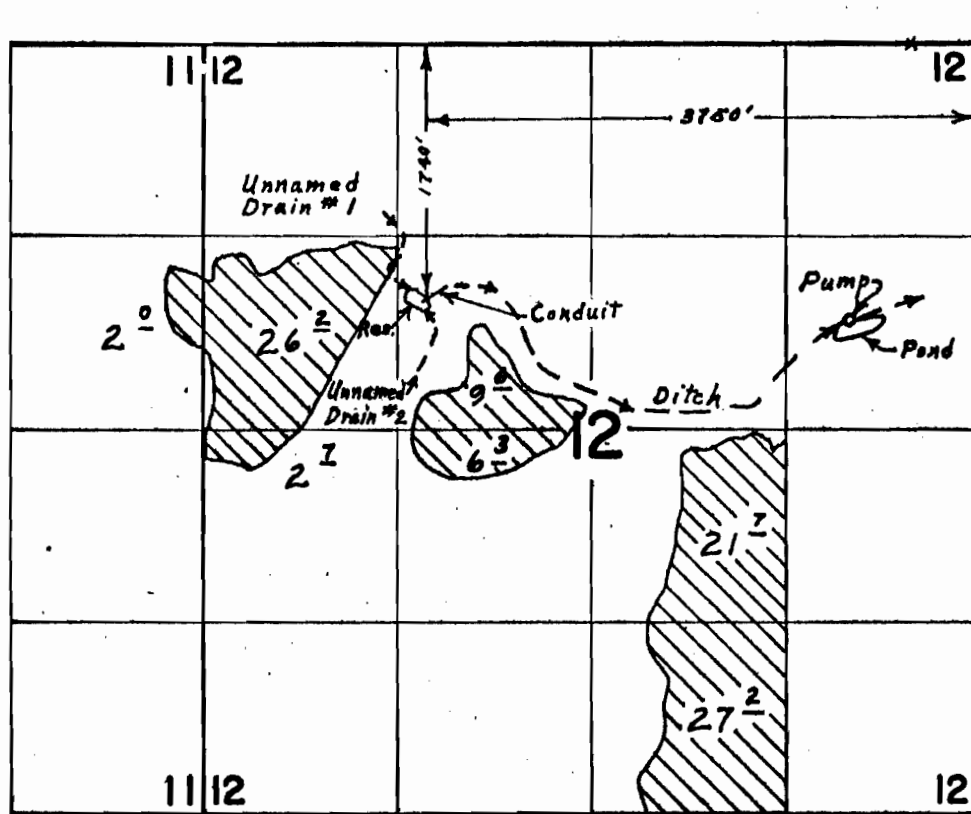

FINAL PROOF SURVEY

UNDER

RA4246

R5048

Application No. 43132 Permit No. 32743

IN NAME OF

MARCUS SACKOS

Surveyed Aug. 13, 1970, by L. E. Gould