


T.9S.R.39E.W.M.

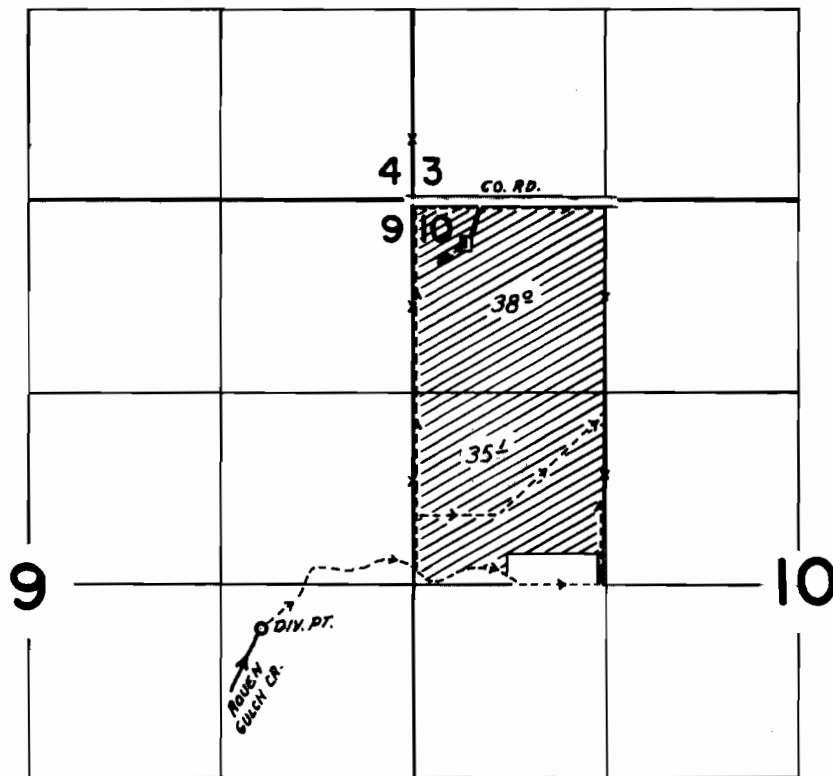

DIV. PT. LOC. 2950' S. & 1050' W. FROM NE COR. SEC. 9

FINAL PROOF SURVEY
UNDER

Application No. 15110 Permit No. 33479
IN NAME OF

DAVID LEE GARDNER

Surveyed JULY 22, 1970, by L. E. GOULD