


T.I.S.R. 4W.W.M.

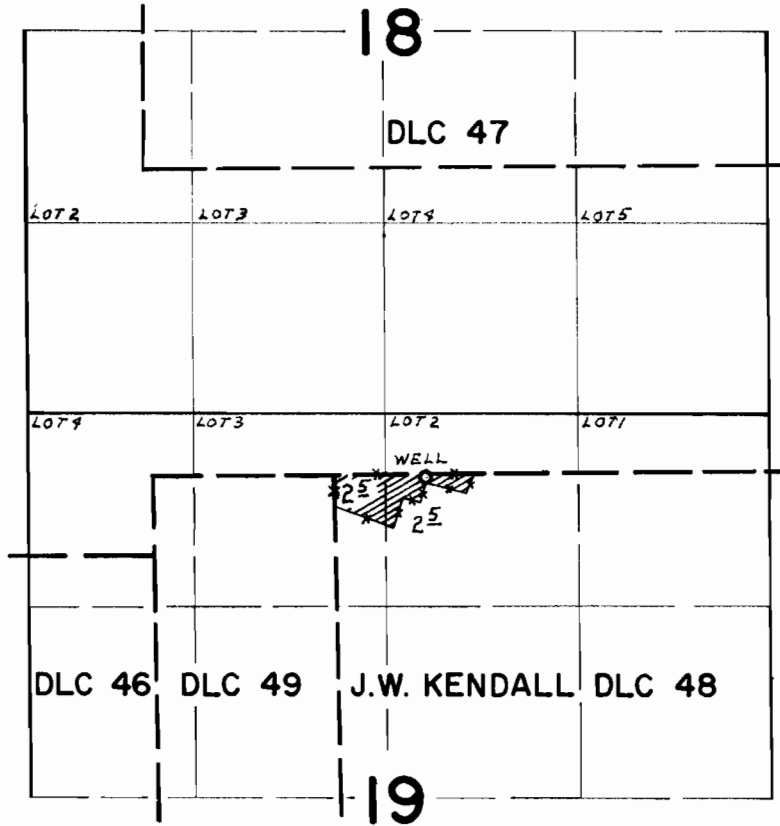

WELL LOC. 20'S. & 63'E. FROM NW COR. J.C. KENDALL DLC 48

FINAL PLAT

Book 1, G-3445

G-3226

Estate of A.L. GUERBER

JULY 30 70

L.E. GOULD