


T. 14 S. R. 5 W. W. M.

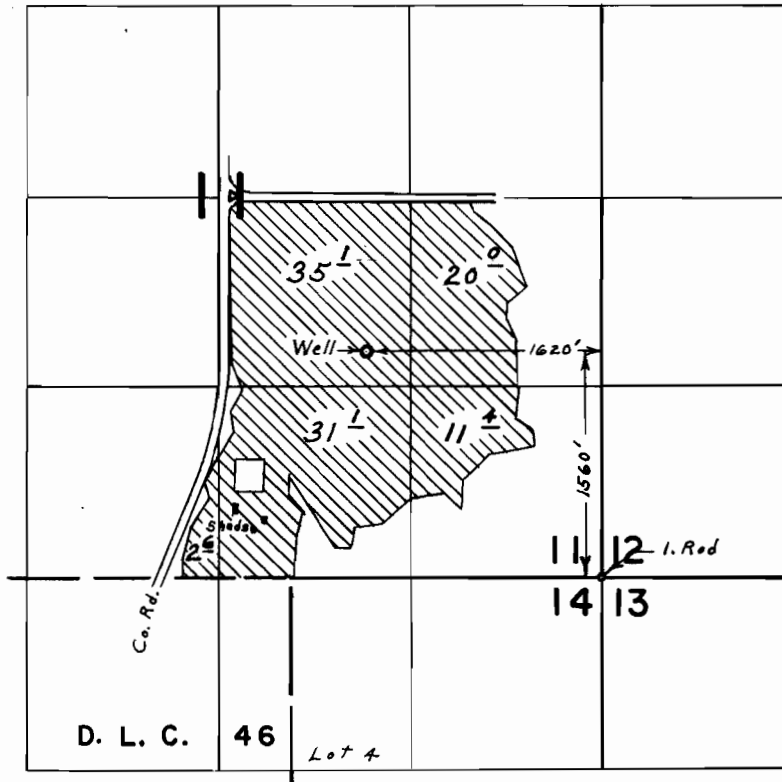

FINAL PROOF SURVEY
UNDER

Application No. G-3540 Permit No. G-3330
IN NAME OF

CARSON & GARY ADAMS

Surveyed April 1, 1970, by L. E. Gould