


# T. 14 S. R. 5 W. W. M.

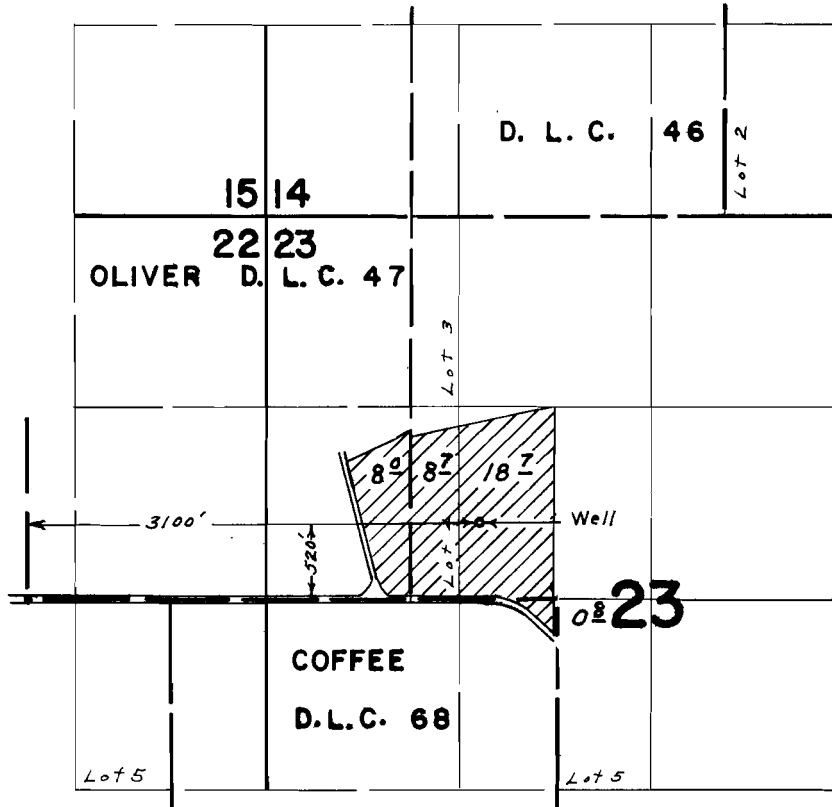

## FINAL PROOF SURVEY

UNDER

Application No. ~~G-4348~~ Permit No. ~~G-4105~~

IN NAME OF

**WILLIAM A. GORACKE**

Surveyed **April 8, 1970**, by **L. E. Gould**