


T. 14 & 15 S. R. 5 W. W.M.

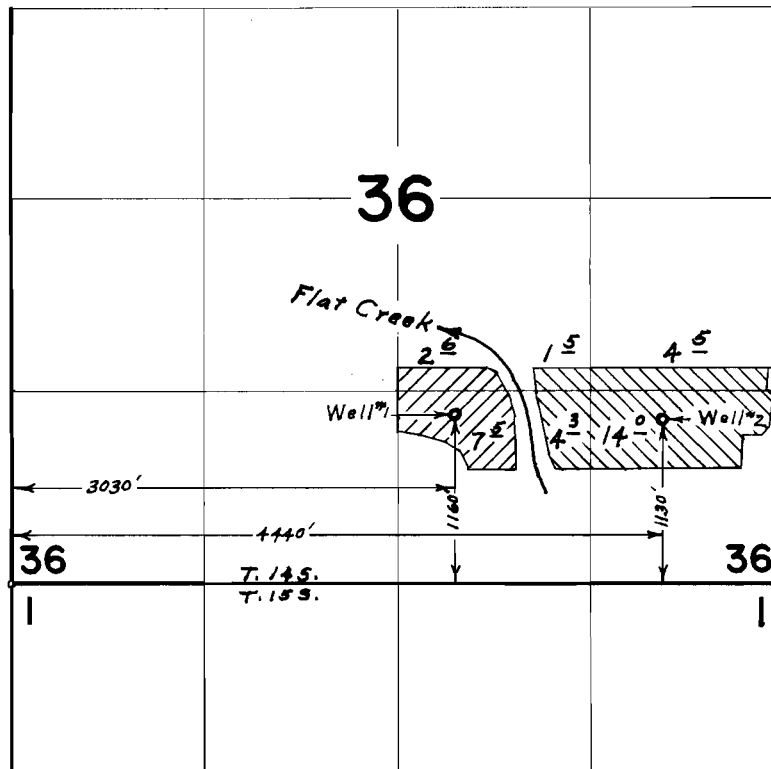

# FINAL PROOF SURVEY

UNDER

Application No. G-4429 Permit No G-4173

IN NAME OF

GORDON F. KELSO

Surveyed May 6, 1970, by L. E. Gould