


T.14 S.R.5 W.W.M.

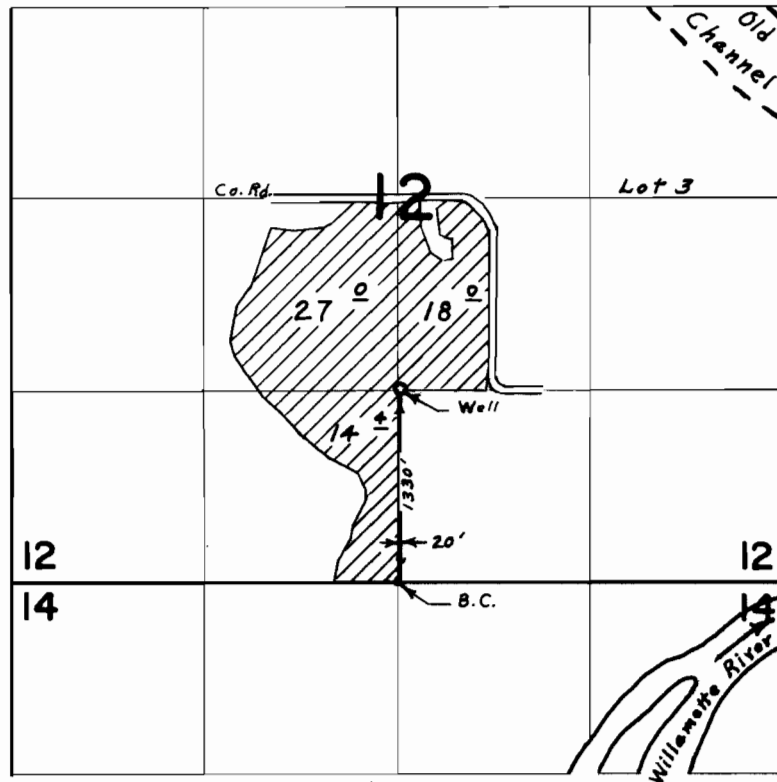

FINAL PROOF SURVEY UNDER

Application No. G-4434 Permit No. G-4177
IN NAME OF

OWEN C. & MURIEL R. GWILLIM

Surveyed April 3, 1970, by L. E. Gould