


# T. 14 S. R. 4 & 5 W. W.M.

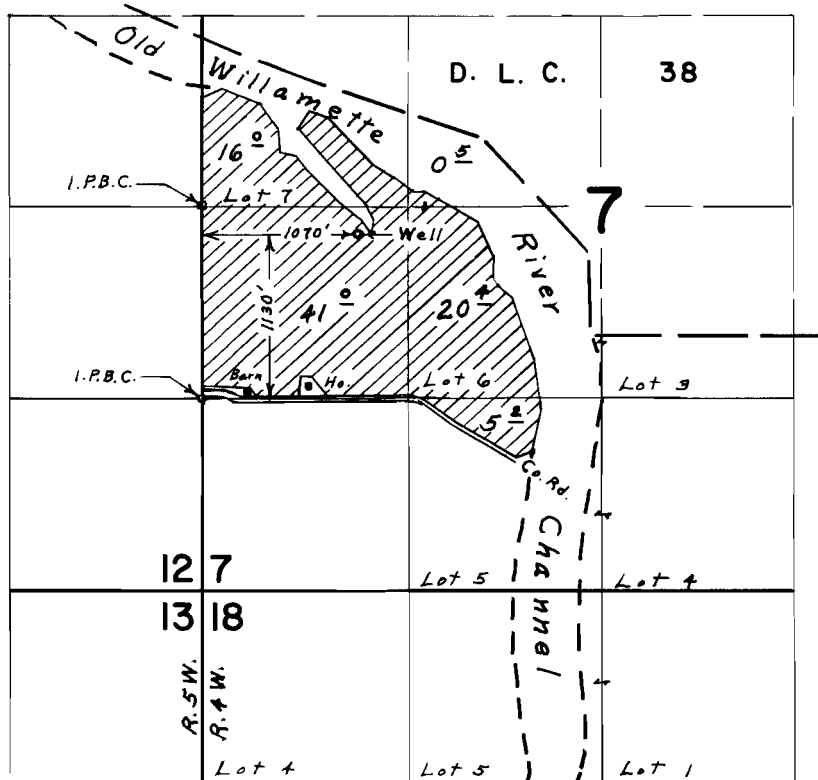

## FINAL PROOF SURVEY UNDER

Application No. G-4503 Permit No. G-4245  
IN NAME OF

**OWEN C. & MURIEL R. GWILLIM**

Surveyed March 23, 1970, by L. E. Gould