


# T.14 S. R. 5 W. W.M.

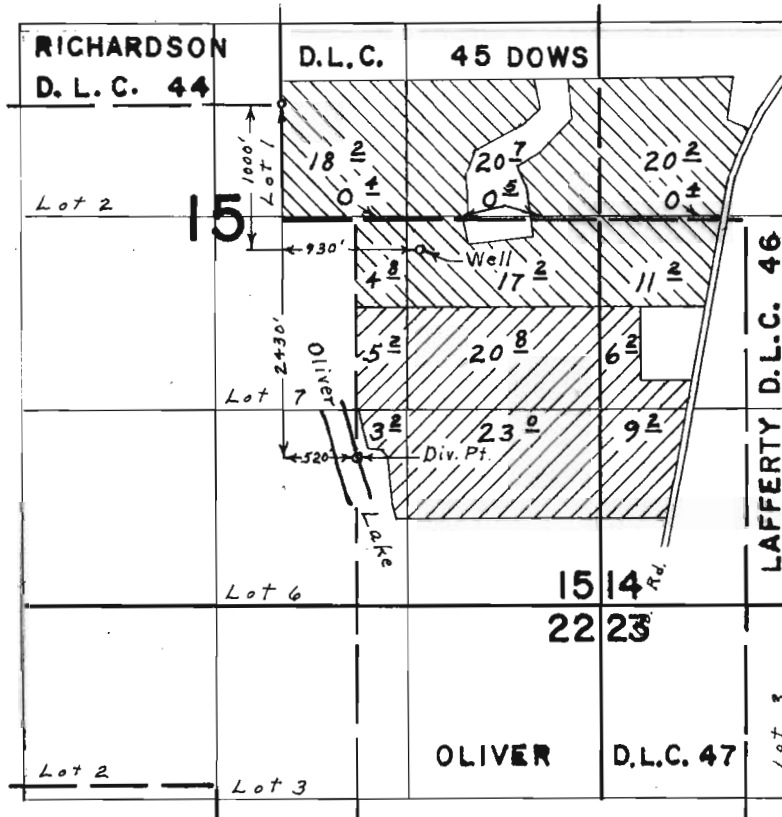

## FINAL PROOF SURVEY

UNDER

Application No. 41314 Permit No. 30849  
G-3217 G-3029



IN NAME OF

E. E. & MABLE M. SMITH

Surveyed March 31, 1970, by L. E. Gould