


T.14S.R.8W.W.M.

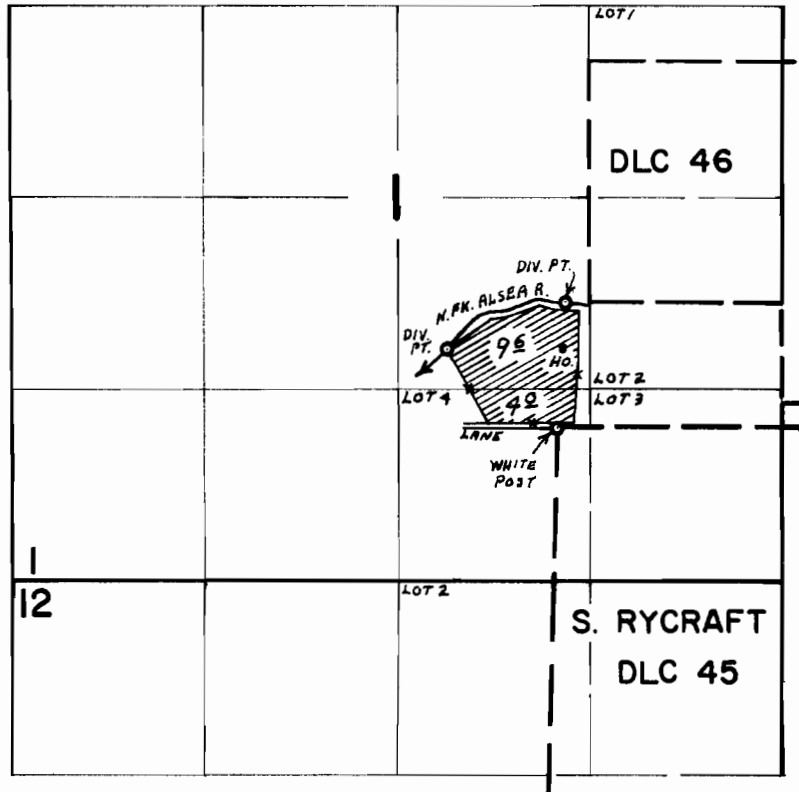

DIV. PTS. LOC.: 550' N. & 760' W.; 860' N. & 60' E.; BOTH FROM NW COR. S. RYCRAFT DLC 45

FINAL SURVEY

37473 27897

Mrs. ANN MARKS

SEPT. 15 1970 L.E. GOULD