


T.13S.R.6W.W.M.

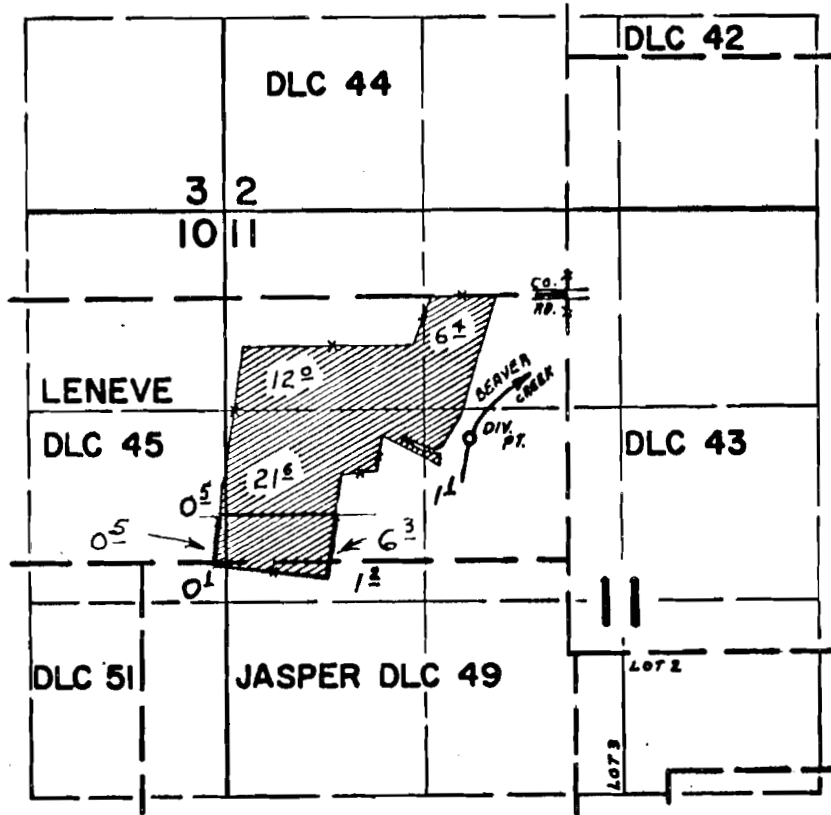

DIV. PT. LOC. 960'S. & 660'W. FROM NE COR. LENEVE DLC 45

FINAL PROOF SURVEY

UNDER

Application No. 40577 Permit No. 30375

IN NAME OF

JOSEPH HECTOR BEELART

Surveyed JULY 31 19 70, by A. E. GOULD