


# T.14S.R.6W.W.M.

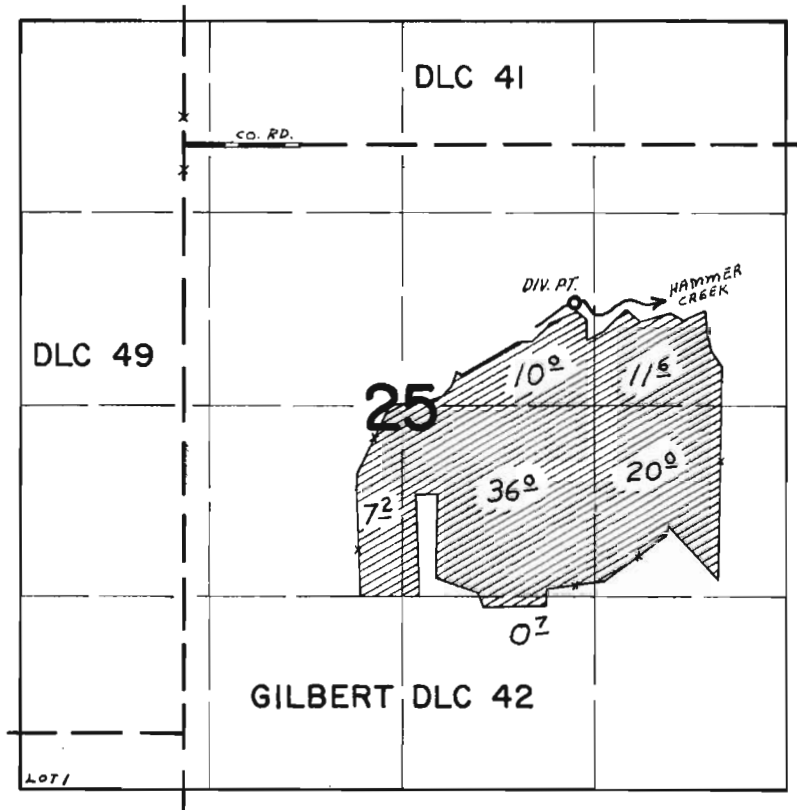

DIV. PT. LOC. 1080' S. & 2680' E. FROM NW COR. GILBERT DLC 42.

## FINAL PROOF SURVEY

UNDER

Application No. 41295 Permit No. 30835

IN NAME OF

CLARE J. MINTONYE and EDNA MINTOYNE

Surveyed AUG. 19 19 70, by L. E. GOULD