


T. 14 S. R. 6 W. W. M.

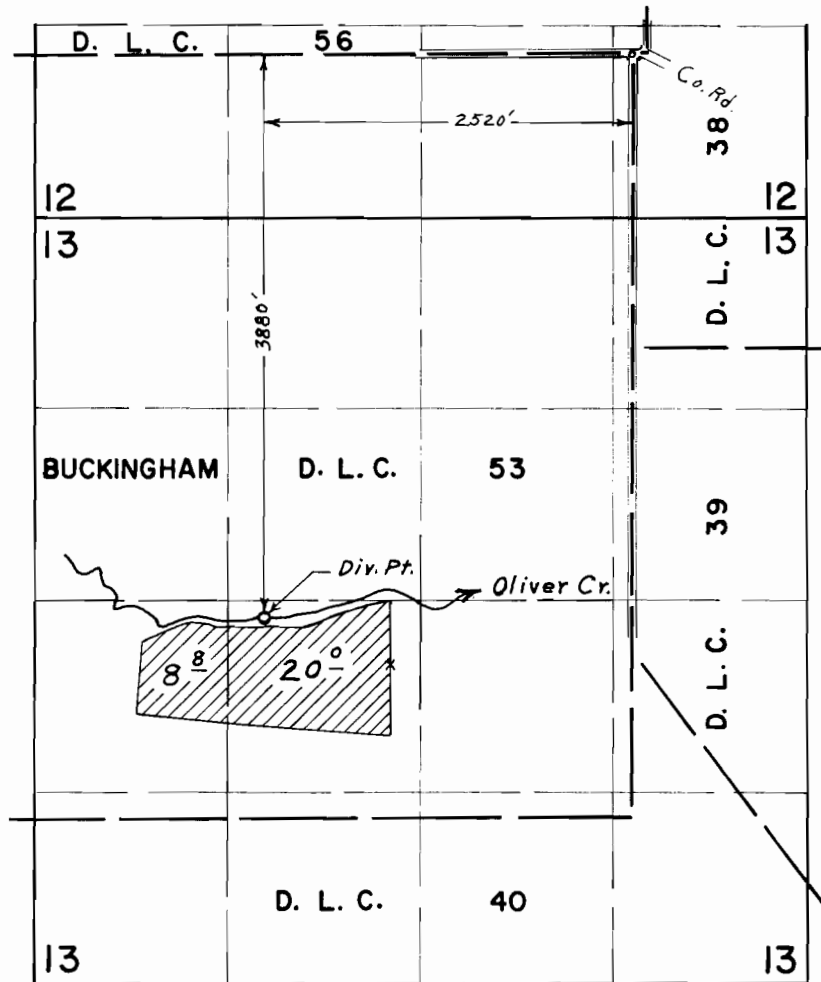

FINAL PROOF SURVEY UNDER

Application No. **42526** Permit No. **31780**
IN NAME OF

LAWRENCE F. CARDA

Surveyed Aug. 19, 1970, by **L. E. Gould**