


# T.14S.R.6W.W.M.

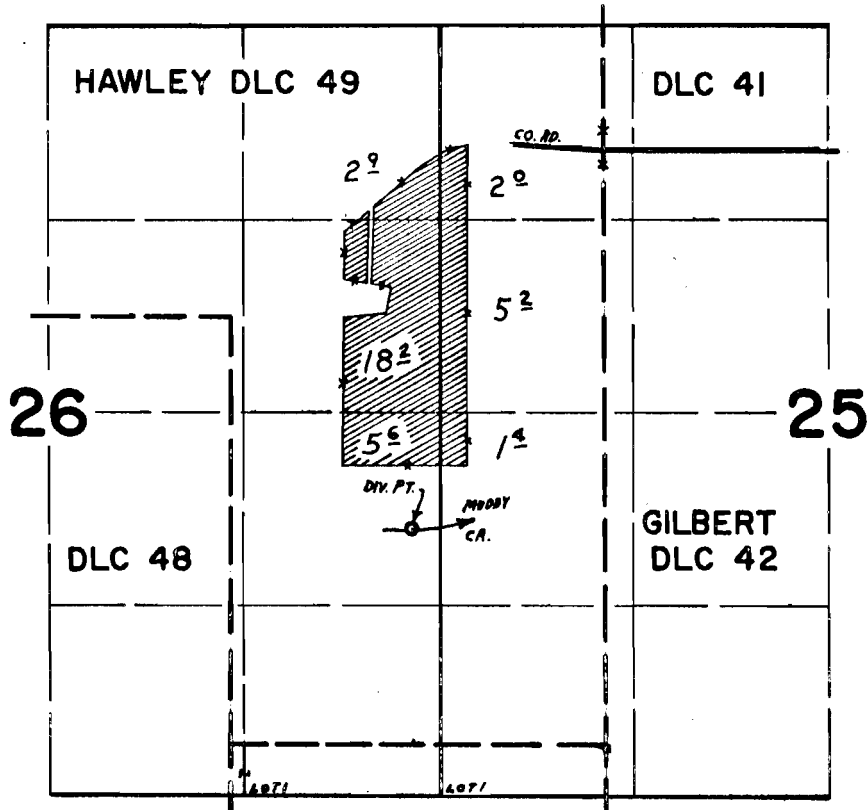

DIV. PT. LOC. 2570'S. #1310' W. FROM NW COR. GILBERT DLC 42.

## FINAL PROOF SURVEY

UNDER

Application No. 42540 Permit No. 31794

IN NAME OF

GILBERT L. CROWSON

Surveyed AUG. 20 19 70., by L. E. GOULD