


# T. 14 S. R. 6 W. W. M.

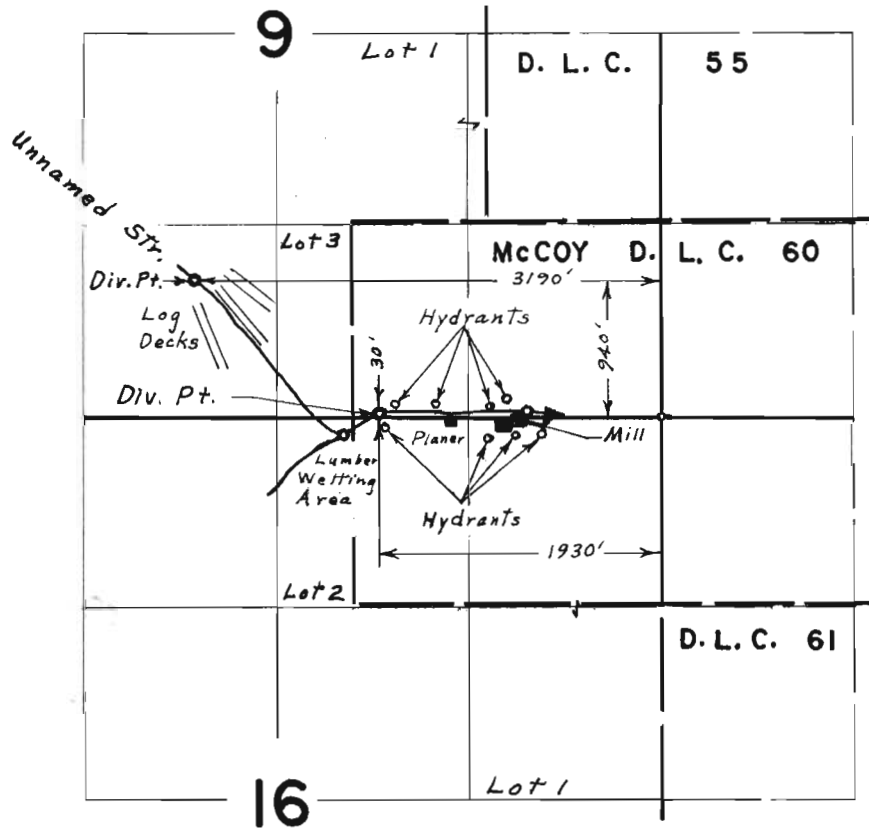

## FINAL PROOF SURVEY

UNDER

Application No. 42206 Permit No. 31936

IN NAME OF

I. P. MILLER LUMBER, INC.

Surveyed May 28, 1970, by L. E. Gould