# T. 13 S. R. 5 W. W.M.

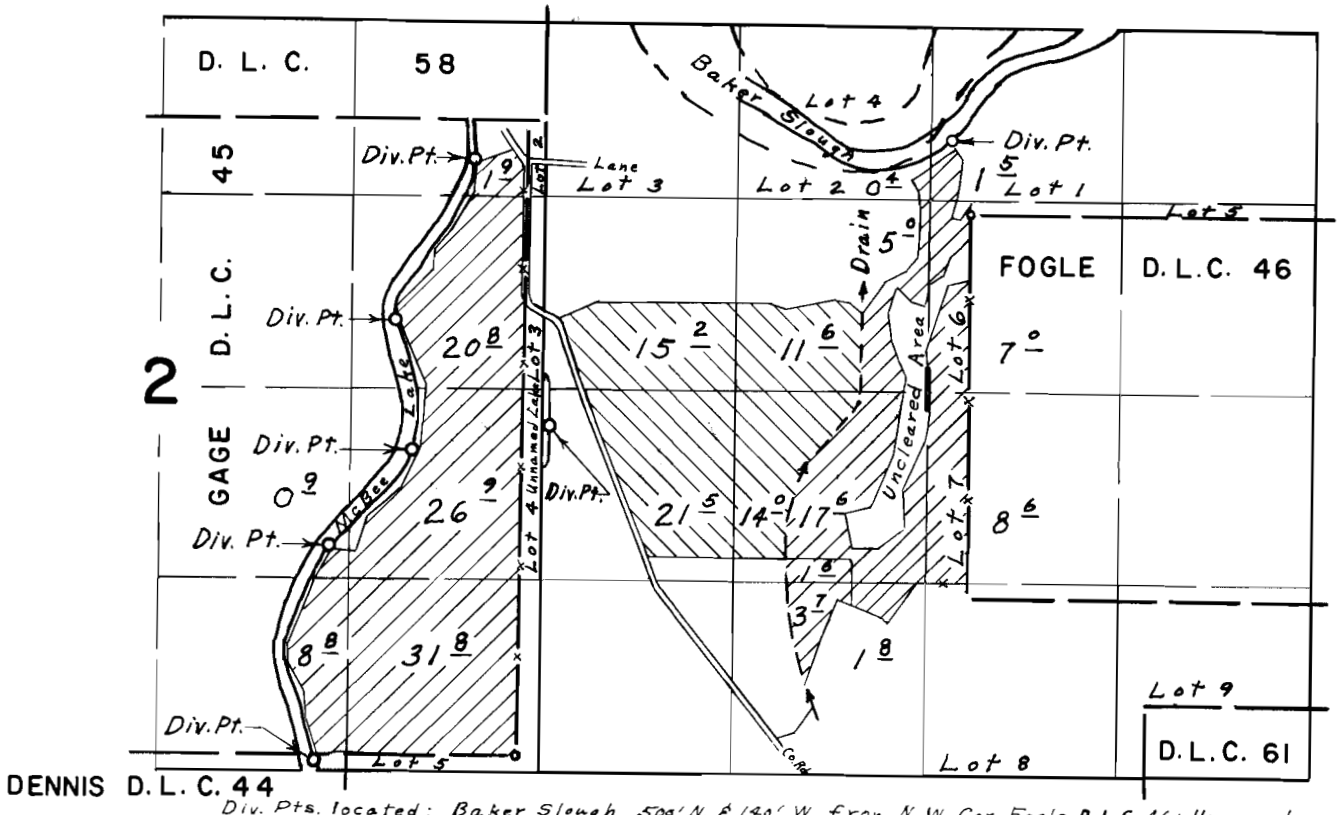


Div. Pts. located: Baker Slough, 500' N. & 140' W. from N. W. Cor. Fogle D.L.C. 46; Unnamed Lake, 2260' N. & 180'; McBee Lake, 4100' N. & 320' W.; 2990' N. & 860' W.; 2100' N. & 720' W.; 1430' N. & 1290' W.; 30' S. & 1380' W.; all from S.E. Cor. Gage D.L.C. 45

FINAL PROOF SURVEY
UNDER

Application No. 43751, 45180, 45181 Permit No. 32695, 33753, 33754

IN NAME OF

CARL LOVELADY

Surveyed Sept. 2, 1970, by L. E. Gould

1970-V