


# T. 13 S. R. 5 W. W.M.

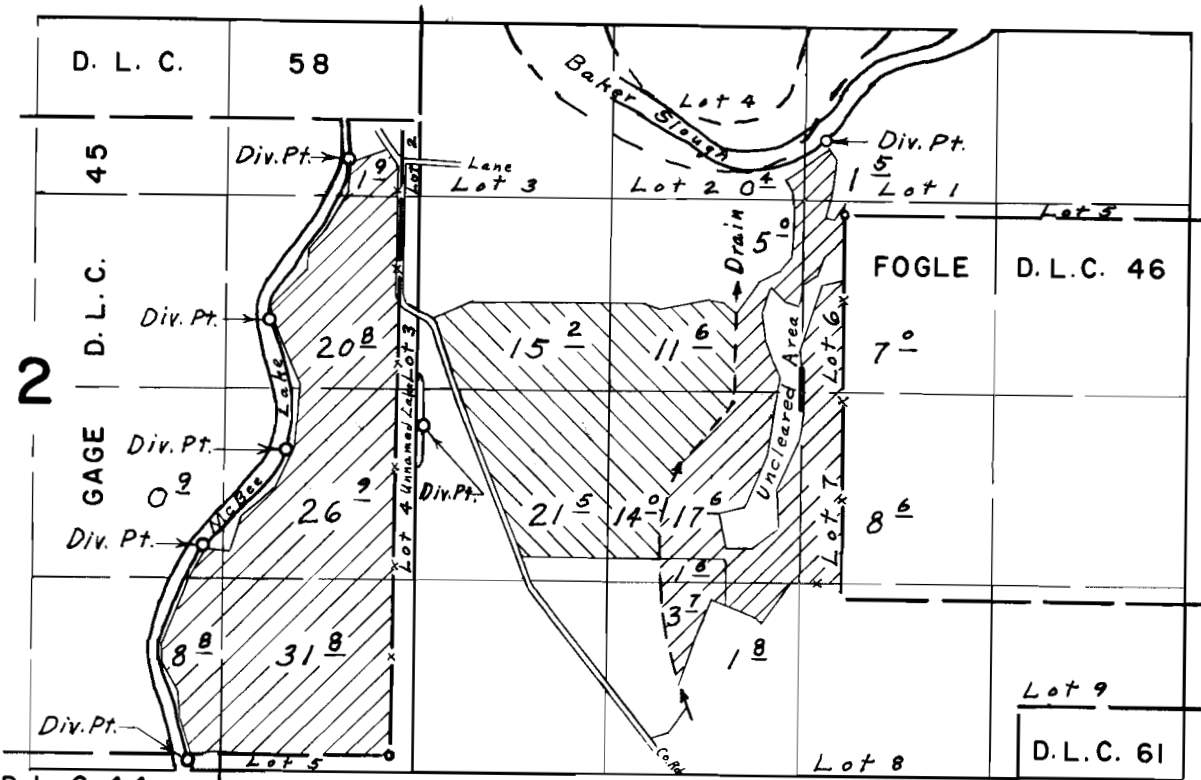

DENNIS D. L. C. 44

Div. Pts. located: Baker Slough, 500' N. & 140' W. from N.W. Cor. Fogle D.L.C. 46; Unnamed Lake, 2260' N. & 180' W.; McBee Lake, 4100' N. & 320' W.; 2990' N. & 860' W.; 2100' N. & 720' W.; 1430' N. & 1290' W.; 30' S. & 1380' W.; all from S.E. Cor. Gage D.L.C. 45

## FINAL PROOF SURVEY UNDER

Application No. **43751**      Permit No. **32695**  
                          **45180**                                      **33753**  
                          **45181**                                      **33754**

IN NAME OF  
**CARL LOVELADY**

Surveyed **Sept. 2, 1970**, by **L. E. Gould**