

Application No. G-2808

Permit No. G-2619

TS-15, R-1E, W.M.  
NW corner of  
SECTION-36


1840-ft.

290-ft.

HARRISON STREET

TRACT-2  
KARLEN'S 2ND  
ADDITION  
Wilhelm Property

WELL

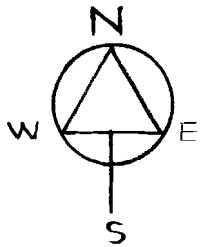

28 STREET


29 STREET

MONROE STREET

S.P. Co.

21 ST.

25 ST.

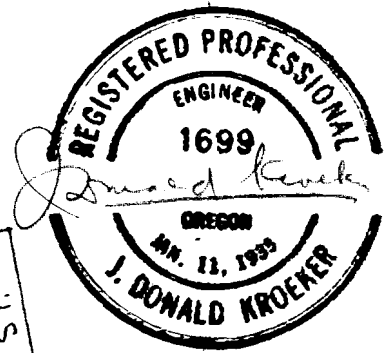

LOCATION OF WILHELM WELL SEC. 36, TS-15, R-1E, WM Milwaukie Oregon	
J. DONALD KROEKER AND ASSOCIATES CONSULTING ENGINEERS 4504 S.W. CORBETT AVE. FORTLAND 1. ORE.	
DATE 3-11-64 JOB 74-1 SCALE 1"=20'	