T.3S.R.1E.W.M.

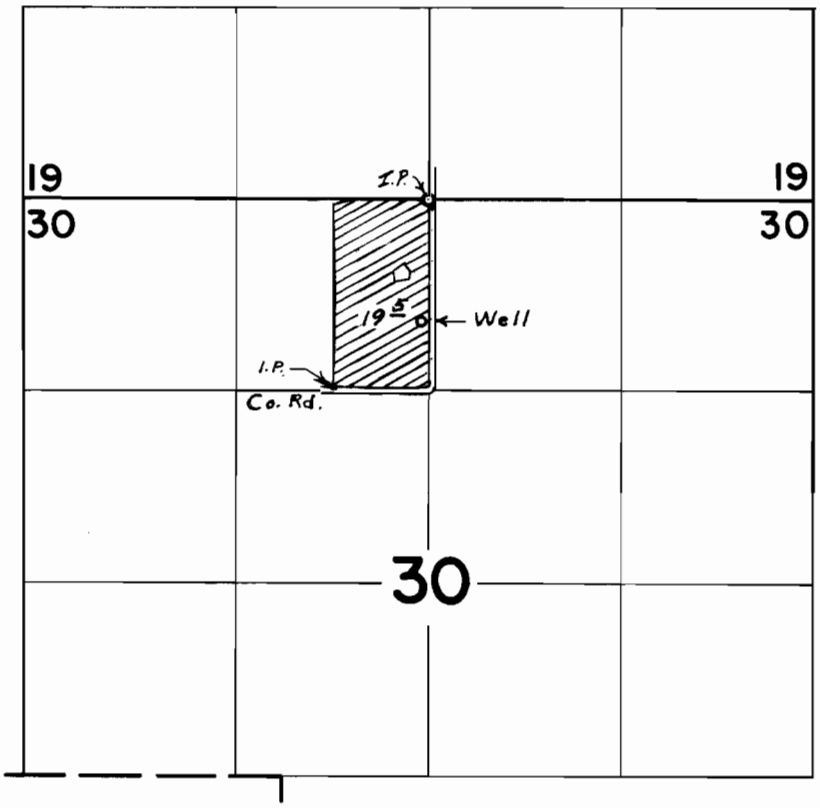

WELL LOC. 840'S. & 50'W. FROM N¼ COR. SEC. 30

FINAL PROOF SURVEY
UNDER

Application No. 6-3557 Permit No. 6-3346
IN NAME OF

CHARLES M. CHEELD

Surveyed NOV. 19 1970, by L.E. GOULD

GB
1970-W