


T.3S.R.3E.W.M.

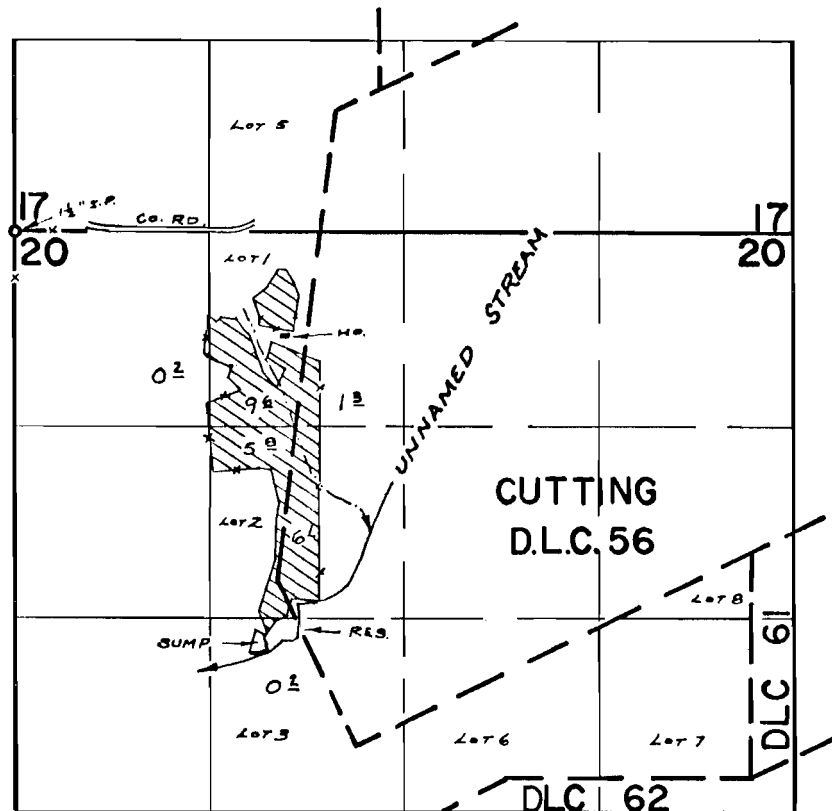

DIV. PTS. LOC: SUMP- 2800'S & 1650'E; RES- 2870'S. & 1720'E,
BOTH FROM N.W. COR. SEC. 20

FINAL PROOF SURVEY

43415 UNDER 32459
G-3864 G-3638
Application No. R-46237 Permit No. R-5501
46238 34545

IN NAME OF

CHARLES ROCKETT

Surveyed Aug 20 1970, by R. MUCKEN