


T.3S.R.3E.W.M.

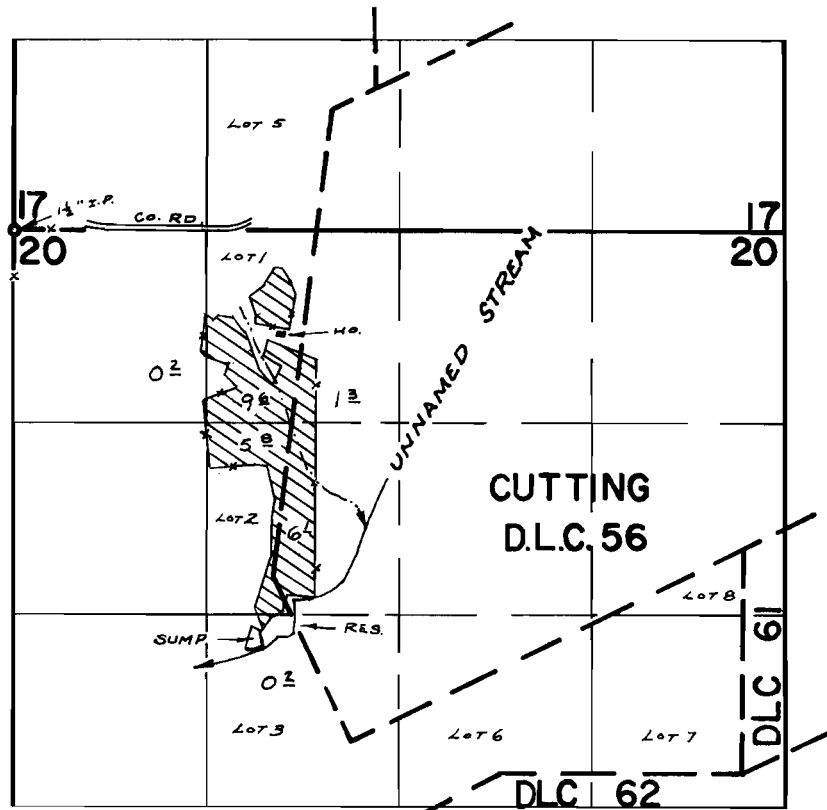

DIV. PTS. LOC: SUMP- 2800'S & 1650'E ; RES- 2870'S. & 1720'E,
BOTH FROM N.W. COR. SEC. 20

FINAL PROOF SURVEY

43415 UNDER

G-3864

R-46237

46238

32459

G-3638

R-5501

34545

Application No. 46238 Permit No. 34545

IN NAME OF

CHARLES ROCKETT

Reviewed Aug 20 1970, by R. MUCKEN