


T.3S.R.3E.W.M.

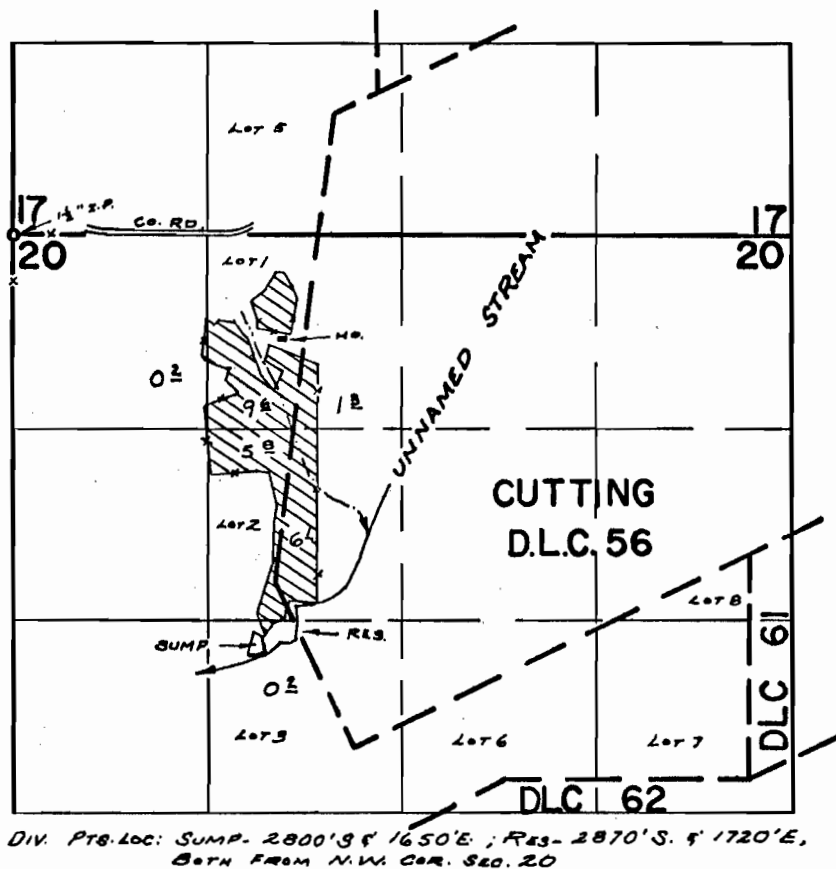

FINAL PROOF SURVEY

43415 UNDER 32459
G-3864 G-3638
R-46237 R-5501
Application No. 46238 Permit No. 34545

IN NAME OF

CHARLES ROCKETT

Surveyed Aug. 20 1970, by R. MUCKEN