


T.3S.R.3E.W.M.

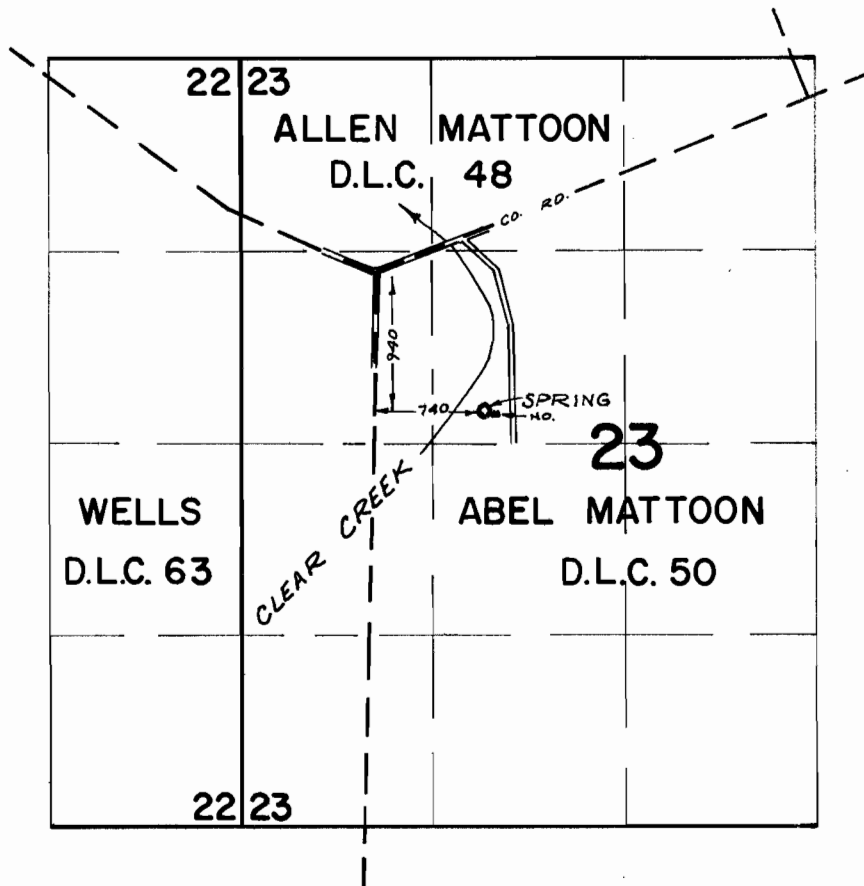

FINAL PROOF SURVEY

FOR

Sections 38965 and 28979

of Town of

RAYMOND L. TRACY

Surveyed Aug. 18, 1970, by R. MUCKEN