


T.6S.R.2E.W.M.

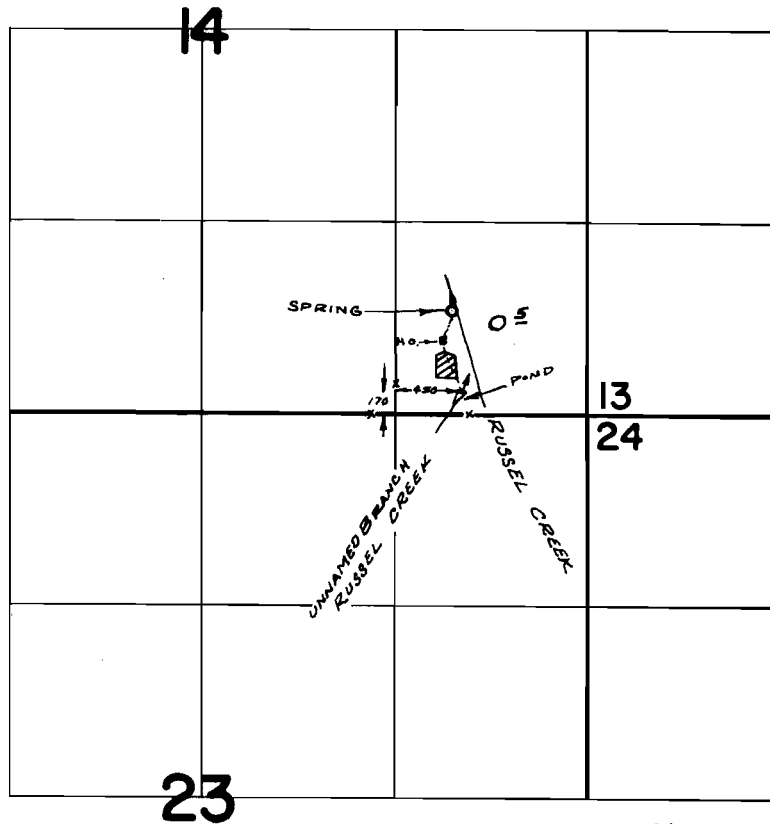

SPRING LOC: 720' N. & 380' E. FROM S.W. COR. SE $\frac{1}{4}$ SE $\frac{1}{4}$ SEC. 14

FINAL PROOF SURVEY
UNDER

Application No. ~~43891~~..... Permit No. ~~32807~~..
IN NAME OF

JOSEPH E. FERLAN

Surveyed MAY 21, 1971, by R. MUCKEN.