


# T. 3 S. R. 1 E. W. M.

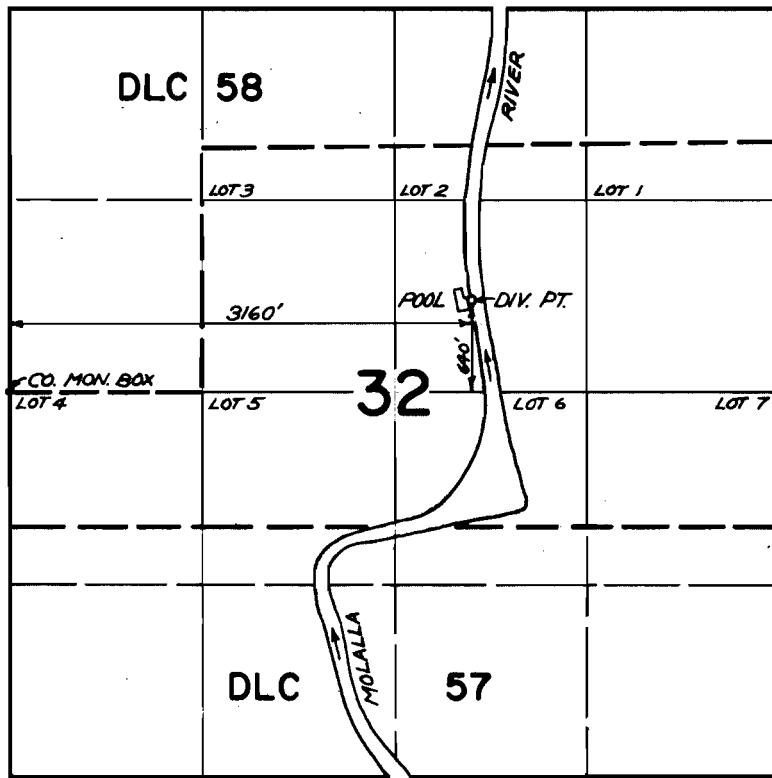

## FINAL PROOF SURVEY UNDER

Application No. 44613 Permit No. 33057  
IN NAME OF

THE CHRISTIAN & MISSIONARY ALLIANCE

Surveyed NOV. 18 1970, by L. E. GOULD