


T.3S.R.4E.W.M.

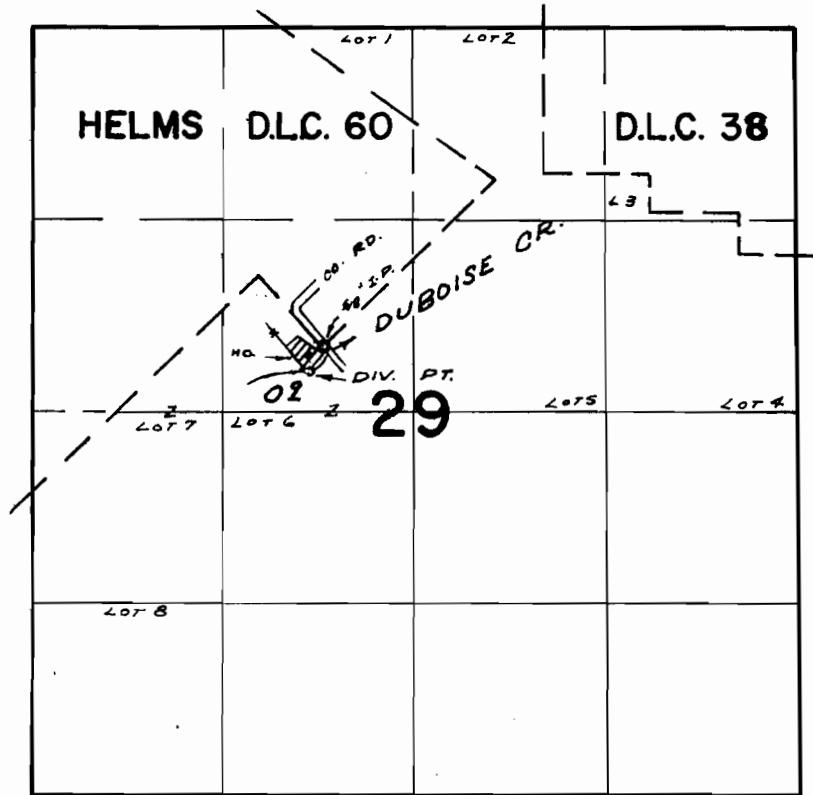

DIV. PT. LOC: 170'S. & 80'W. FROM E. RE-ENTRANT COR. D.L.C. 60

FEDERAL GOVERNMENT SURVEY

UNDER

Section No 45090 Twp. 33S. R. 4E. W.M.

IN NAME OF

WARREN T. or FLORENCE P. JOHNSTON

Surveyed AUG. 19, 1970 by R. MUCKEN