


T.23S.R.7W.W.M.

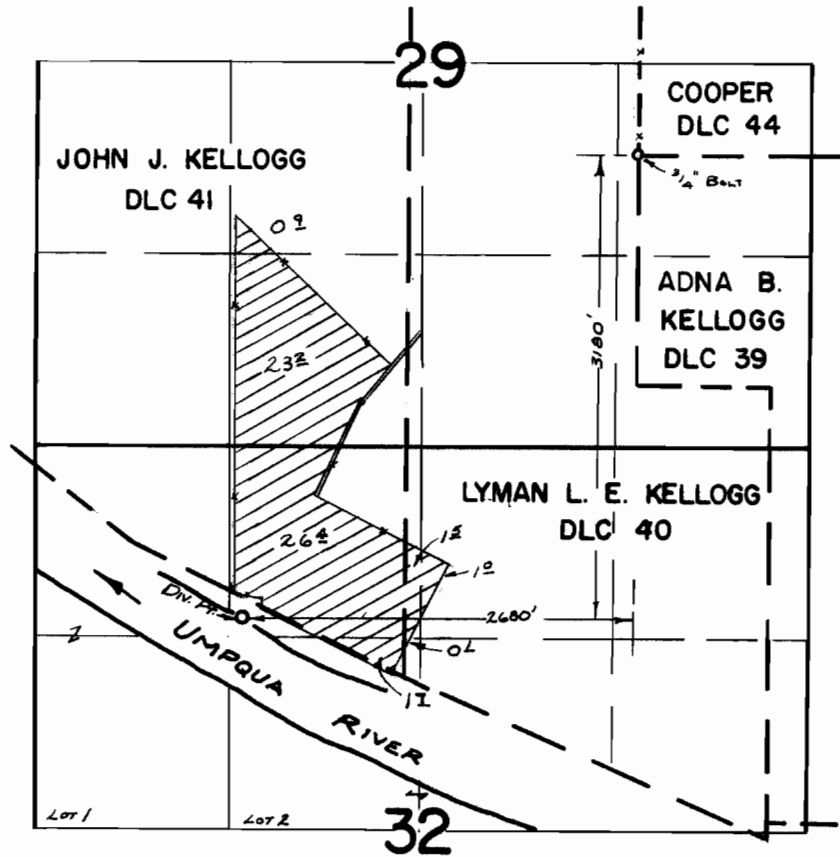

FINAL PROOF SURVEY
UNDER

Application No. 39851 Permit No. 29666
IN NAME OF

C. ELDON FISHER

Surveyed JUNE 3, 1970, by R. MUCKEN