


T. 22 S. R. 5 W. W. M.

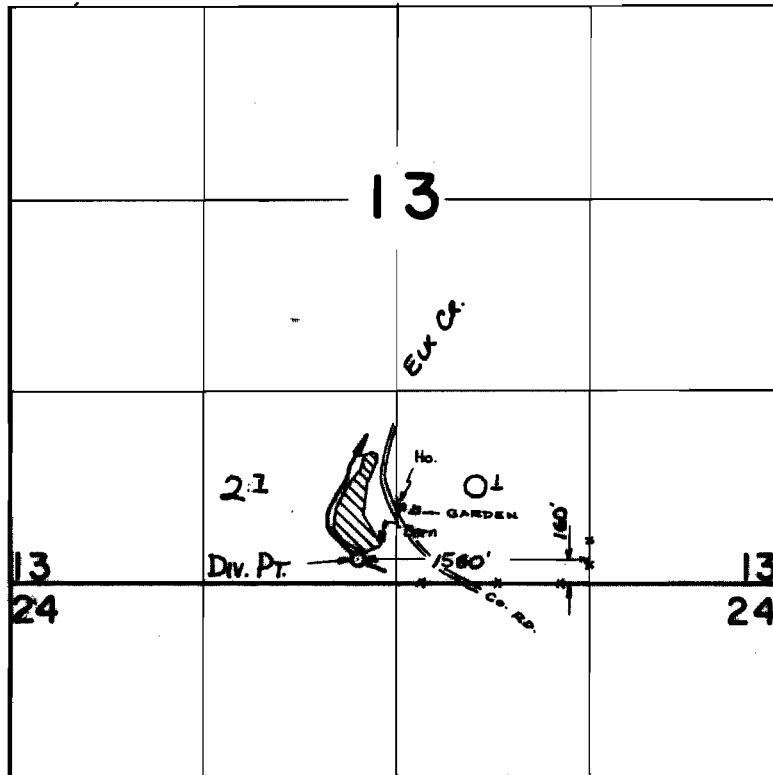

**FINAL PROOF SURVEY**  
UNDER

Application No. 41351..... Permit No. 30888.....  
IN NAME OF

.....**ROY E. COX**.....

Surveyed 15 JUNE 1970, by R.G. MUCKEN.....