


T.21S.R.4W.W.M.

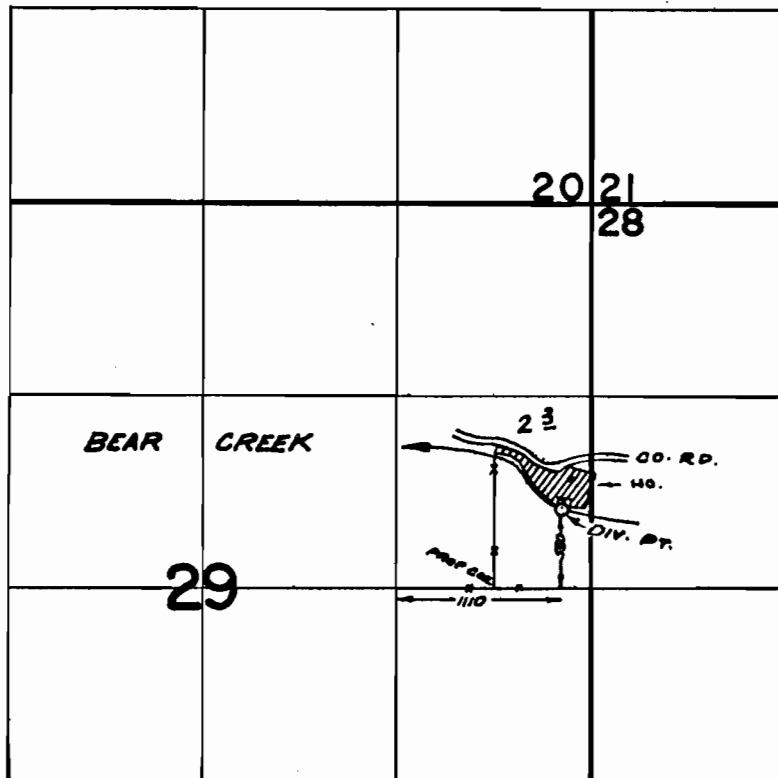

FINAL PROOF SURVEY

UNDER

Application No. 41377 Permit No. 30909

IN NAME OF

MORRIS L. & COLETTE CULVER

Surveyed JUNE 18 19 70, by R. MUCKEN