


T.23S.R.7W.W.M.

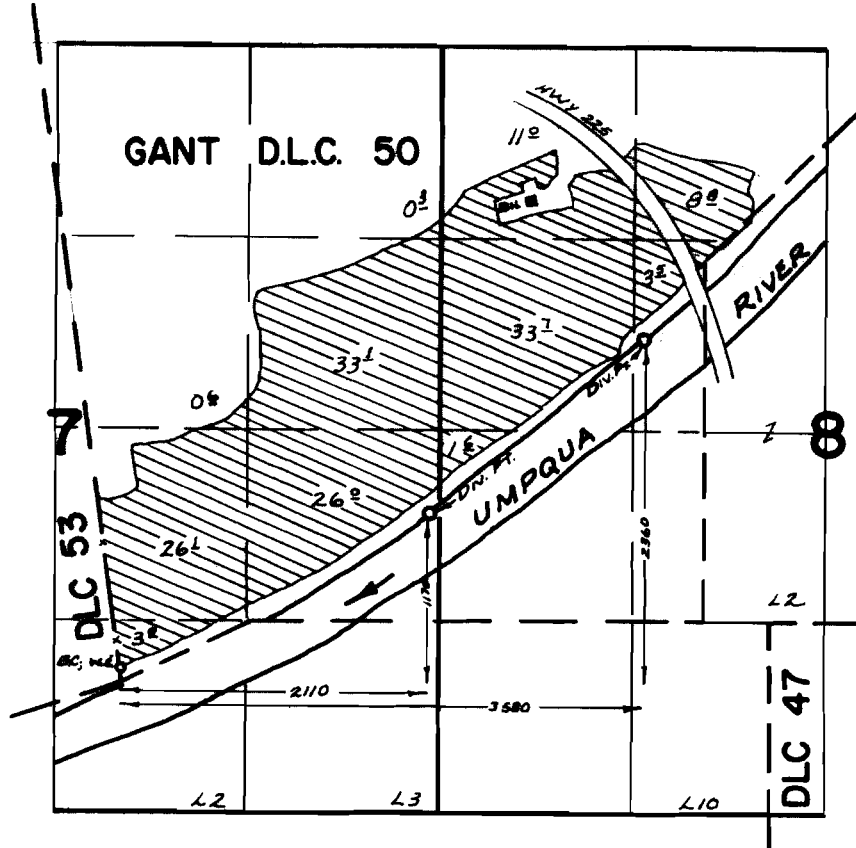

FINAL PROOF SURVEY
UNDER

Application No. 42044 Permit No. 31472

IN NAME OF
GEORGE W. NEUNER
TRUSTEE FOR CAROL A. & ROBERT J. WHIPPLE

Surveyed June 4, 1970, by R. MUCKEN