


T.23S.R.5W.W.M.

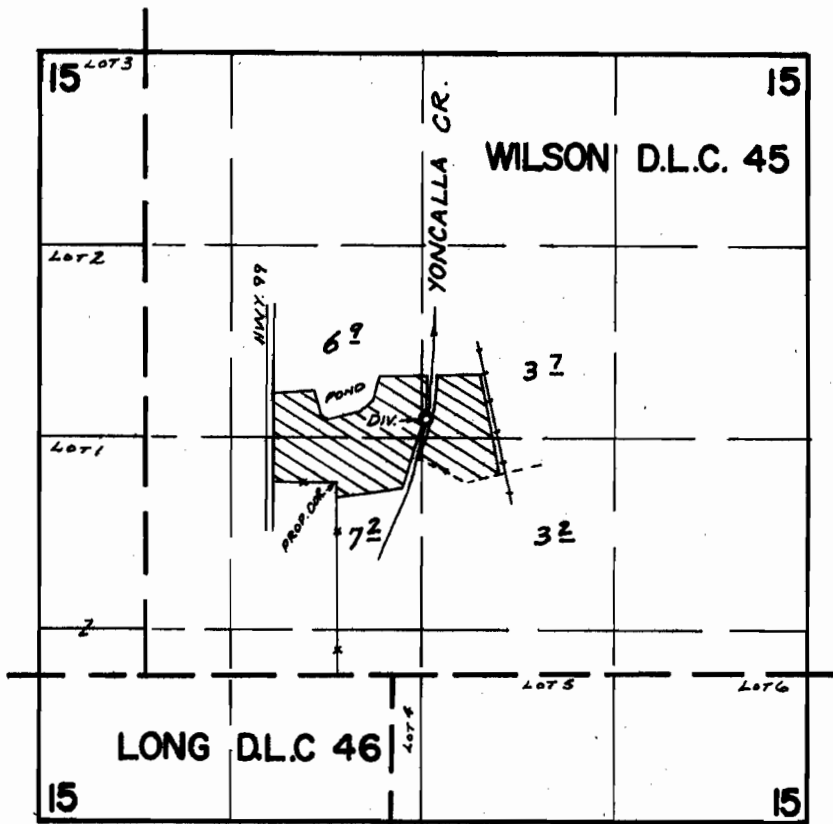

DIV. PT. LOC: 1930'E. & 1760'N. FROM S.W. COR. D.L.C. 45

FINAL PROOF SURVEY

UNDER

Application No. 42466 Permit No. 31762

IN NAME OF

HAROLD T. & GLORIA D. STROMBERG, JR.

Surveyed JUNE 17 19 70, by R. MUCKEN