


T.23S.R.7W.W.M.

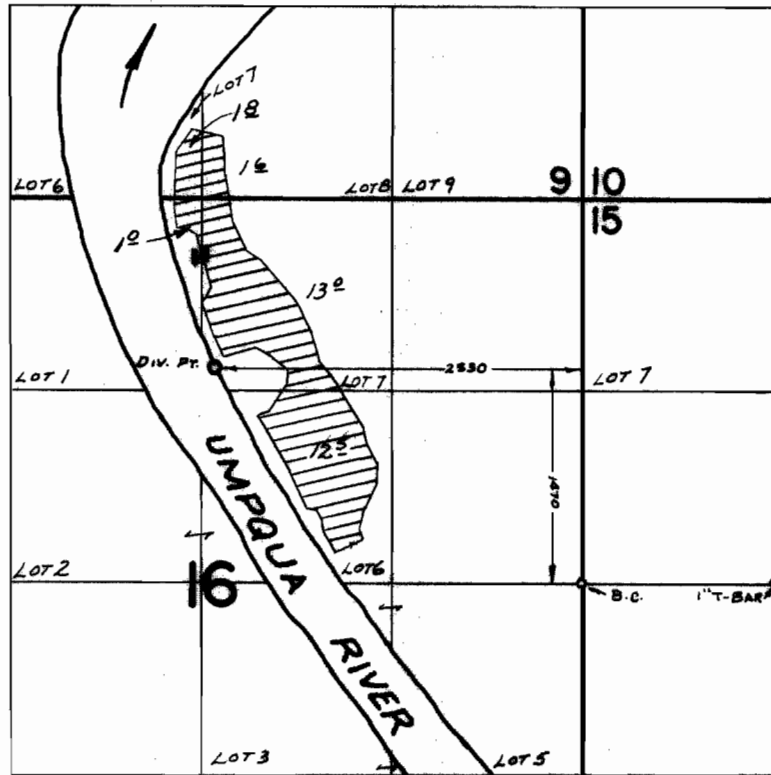

FINAL PROOF SURVEY
UNDER

Application No. 43567 Permit No. 32582
IN NAME OF

JIM S. WHIPPLE

Surveyed JUNE 11, 1970, by R. MUCKEN